

**LAND CORNER RECORDATION CERTIFICATE**  
 Filing Requirement of Act 74, Mich. P.A. 1970

\$ 7.00 MISCELLANEOUS RECORDING  
 \$ 2.00 REMONUMENTATION  
 27 JUL 95 3:33 P.M. RECEIPT# 1408  
 PAID RECORDED - OAKLAND COUNTY  
 LYNN D. ALLEN, CLERK/REGISTER OF DEEDS

For corners in

	Oakland (County)	Located in:	Addison Township	Corner Code #
1. Public Land Survey		T	5N R 11E	D-11
		T	R	
		T	R	
		T	R	
2. Property Controlling in Section	S	T	R	
	S	T	R	
3. Miscellaneous Property in Sec.	S	T	R	
	S	T	R	


Compliance with  
 ACT 345, P.A. 1990  
 APPROVED ON: 6-26-95 TWS  
 OAKLAND COUNTY REMONUMENTATION  
 PEER GROUP COMMITTEE

Register of Deeds Stamp & File Number

4. Lot No. \_\_\_\_\_, Recorded Plat \_\_\_\_\_  
 5. Private Claims \_\_\_\_\_

I, Randy Kolehouse, in a field survey on May 12 19 95, do hereby certify that under requirements of P.A. 74 Michigan P.A. of 1970, the corner points mentioned in lines 1 and 2 above were in conformance with regulations and rules therefore as required in the current manual of survey instructions of the United States Department of the interior, Bureau of Land Management or by a decree of a Court of Law and/or that the corner points mentioned in lines 3, 4 and 5 above were in conformance with the rules of the Michigan Board of Land Surveyors or by a Decree of a Court of Law; established, re-established, monumented, re-monumented, recovered, found as expressed below:

**NOTE:** Not more than 4 corners, all in the same town and range, may be recorded on this certificate.

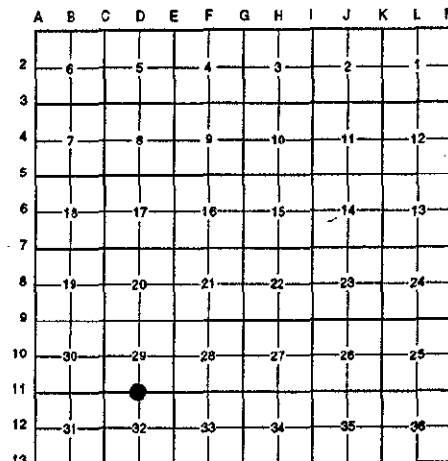

**A. Description of original monument and accessories and/or subsequent restoration:**

D-11 1817	Wampler	G.L.O.	Set Post
	Carnahan	Unrecorded Survey	
1993	Ward	L.C.R.C. L. 13490 P. 480 & 481	Iron Rod (Under Water)

**B. Description of corner evidence found and/or method applied in restoring or reestablishing corner:**

D-11 Found 1/2" capped iron #13029 in a swamp on the C/L of Drahner Road extended. Drahner Road goes along the North side of this swamp. Iron was just below surface of water. Location agrees with witnesses of L.C.R.C. L. 13490 P. 480 & 481.

Ward L.C.R.C. L. 13490 P. 480-481 1993  
 North 6.56' PK & Disc. #17623 W Face 14" Maple  
 S 80° W 10.45' PK & Disc. #17623 N Face 8" Maple  
 South 15.07' PK & Disc #17623 W Face 10" Maple  
 S 70° E 22.60' Nail S Face 14" Maple

G.L.O. Distance to C-11 and E-11 = 39.90' Ch. (2633.4')  
 Carnahan Survey = 2573.0' to E-11  
 Measured D-11 to E-11 = 2572.62'  
 Measured D-11 to C-11 = 2700.50'  
 Measured C-11 to E-11 = 5273.12' (G.L.O. 5266.8')

**C. Description of monument for corner and accessories established to perpetuate locating the position of the corner:**


D-11 Replaced capped iron with a 4" x 36" concrete monument with brass cap stamped "Oakland County Remonumentation P.S. #25854."

PK Nail & Tag Stamped "Oakland Co. Remonumentation P.S. #25854" in W Side 15" Maple North 6.45'  
 PK Nail & Tag Stamped "Oakland Co. Remonumentation P.S. #25854" in S Side 12" Maple S 65° E 22.62'  
 PK Nail & Tag Stamped "Oakland Co. Remonumentation P.S. #25854" in W side 10" Maple S 10° W 15.24'  
 PK Nail & Tag Stamped "Oakland Co. Remonumentation P.S. #25854" in N Side 8" Twin Maple West 10.42'

The selected location is accepted by the Contractor and is generally accepted by professional surveyors as the best available evidence of the position of the original corner.

Signed by Randy J Kolehouse Date 7/14/95  
 EARTH TECH

Surveyor's Michigan License No. 25854

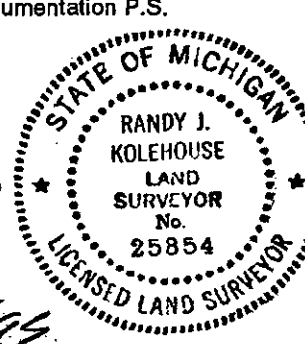

*7.00  
 2.00 amt  
 file*