

LAND CORNER REGORDATION CERTIFICATE
Filing Requirement of Act 74, Mich. P.A. 1970

\$ 9.00 MISCELLANEOUS RECORDING
\$ 2.00 REMONUMENTATION

27 JUL 95 3:32 P.M. RECEIPT# 1408
PAID RECORDED - OAKLAND COUNTY
LYNN D. ALLEN, CLERK/REGISTER OF DEEDS

For corners in

Oakland
(County)

Located in: Addison Corner Code #
Township

1. Public Land Survey	T	5N	R	11E	I-11
	T		R		
	T		R		
	T		R		
2. Property Controlling in Section	S		T		R
	S		T		R
3. Miscellaneous Property in Sec.	S		T		R
	S		T		R

Compliance with
ACT 345, P.A. 1990


APPROVED ON: 6-26-95 Tom S
OAKLAND COUNTY REMONUMENTATION
PEER GROUP COMMITTEE

Register of Deeds Stamp & File Number

4. Lot No. _____, Recorded Plat _____
5. Private Claims _____

I, Randy Kolehouse, in a field survey on June 19 95, do hereby certify that under requirements of P.A. 74 Michigan P.A. of 1970, the corner points mentioned in lines 1 and 2 above were in conformance with regulations and rules therefore as required in the current manual of survey instructions of the United States Department of the interior, Bureau of Land Management or by a decree of a Court of Law and/or that the corner points mentioned in lines 3, 4 and 5 above were in conformance with the rules of the Michigan Board of Land Surveyors or by a Decree of a Court of Law; established, re-established, monumented, re-monumented, recovered, found as expressed below:

NOTE: Not more than 4 corners, all in the same town and range, may be recorded on this certificate.

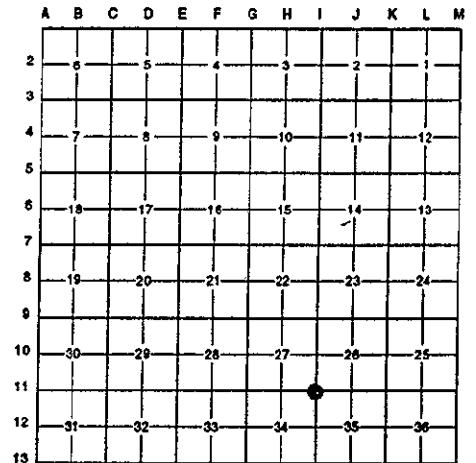

A. Description of original monument and accessories and/or subsequent restoration:

1817	Wampler	G.L.O.	Set Post
1965	O.C.R.C.	File #140	Found Iron Pin C/L of Road
1977	Buckerfield	L.C.R.C. L. 7152 P. 135	Found 1/2" Pipe

See back for continuation.

B. Description of corner evidence found and/or method applied in restoring or reestablishing corner:

I-11 Found a 1/2" pipe at the C/L of Rochester Road (asphalt) 3" below surface in line with tree row to South which checks one remaining witness from 1965 O.C.R.C. Section corner File #140 as well as witnesses shown above in surveys and L.C.R.C.'s from 1977 to present.

Buckerfield L.C.R.C. L. 7152 P. 135 N 70° E 71.90' Sign Post S 40° E 41.20' D.E. Pole South 37.37' PK in Twin 16" Oak	Kobs L.C.R.C. L. 9418 P. 95 and Cert Survey L. 9418 P. 75 PK in P. Pole SE 41.23' Form Nail in 18" Twin Oak South 37.18' PK in 8" Sassafras SW 48.50' PK in 14" Twin Sassafras WSW 90.84'
--	---

Avey L.C.R.C. L. 13284 P. 761 and Cert. Survey L. 13284 P. 747-750
40.06' SE to Form Nail w/Shiner #17623 W Side Util. Pole
37.00' South to PK W Side 2-18" Oaks
48.47' SW to PK NW Side 8" Oak

Buckerfield Measured West 2535.94' to H-11 Kobs Measured West 2535.94' to H-11 King Measured East 2900.18' to J-11	Kennedy Measured East 2900.16' to J-11 Avey Measured North 2757.41' to I-10
--	--

C. Description of monument for corner and accessories established to perpetuate locating the position of the corner:

I-11 Replaced the 1/2" pipe with a 5/8" x 24" rebar with brass cap stamped "Oakland County Remonumentation P.S. #25854." Also set monument box.

- PK Nail & Tag Stamped "Oakland Co. Remonumentation P.S. #25854" in S Face 36" Oak N 87° E 184.76'
- PK Nail & Tag Stamped "Oakland Co. Remonumentation P.S. #25854" in NE Face P. Pole S 30° E 41.18'
- PK Nail & Tag Stamped "Oakland Co. Remonumentation P.S. #25854" in S Face P. Pole S 79 W 119.83'
- PK Nail & Tag Stamped "Oakland Co. Remonumentation P.S. #25854" in S Face P. Pole N 58° W 88.63'

The selected location is accepted by the Contractor and is generally accepted by professional surveyors as the best available evidence of the position of the original corner.



Signed by Randy J. Kolehouse Date 7/14/95
EARTH TECH
Surveyor's Michigan License No. 25854

9.00
2.00 Rem
file

LISER 15550 PG 258

Part "A" Continued

A.	1982	Kennedy	L.C.R.C. L. 8132 P. 541	Found 1/2" Iron Rod
	1983	Kennedy		Found Iron Pipe
	1984	Kennedy	L.C.R.C. L. 8599 P. 135	Found Iron Pipe in C/L Rochester Road
	1979	Kobs	L. 7630 P. 321	1/2" Pipe
	1985	Kobs	L.C.R.C. L. 9418 P. 95 and Cert. Survey L. 9418 P. 75	Found 1/2" Pipe
	1987	King	L. 10209 P. 44-47 and P. 48-49	1/2" Iron Pipe
	1988	King	L. 11488 P. 245	Found 1/2" Pipe
	1989	Buckerfield	Unrecorded	
	1989	Kobs	Unrecorded	Found 1/2" Pipe
	1990	Heil	Unrecorded	
	1990	Kobs	L. 11501 P. 118	Found 1/2" Pipe
	1991	Kennedy	L. 13322 P. 089-092	Found 1 Iron Pipe
	1992	Avey	L.C.R.C. L. 13284 P. 761 and L. 13284 P. 747-750	Found 1/2" Bar
	1992	Van Havermaat	Unrecorded	Found Iron Pipe
	1992	King	L. 13106 P. 593-607	Found 1/2" Pipe
	1993	King	L. 13923 P. 089/90	Found 1/2" Pipe