

**SURVEY &
REMONUMENTATION**

MAY - 1 1995

LIBER 14833 PG 121

LAND CORNER RECORDATION CERTIFICATE
Filing Requirement of Act 74, Mich. P.A. 1970

94 193365

COMMISSION

OK - T. SMITH

For corners in
Oakland

	Located In:		Corner Code #
	5N	11E	
1. Public Land Survey	T _____ R _____	_____	K-3
	T _____ R _____	_____	
	T _____ R _____	_____	
	T _____ R _____	_____	
2. Property Controlling in Section	S _____ T _____ R _____	_____	
	S _____ T _____ R _____	_____	
3. Miscellaneous Property in Sec.	S _____ T _____ R _____	_____	
	S _____ T _____ R _____	_____	
4. Lot No. _____, Recorded Plat _____			
5. Private Claims _____			

\$ 7.00 MISCELLANEOUS RECORDING
\$ 2.00 REMONUMENTATION
15 JUL 94 7:28 A.M. RECEIPT# 1A
PAID RECORDED - OAKLAND COUNTY
LYNN D. ALLEN, CLERK/REGISTER OF DEEDS
Compliance with
ACT 345, P.A. 1990

APPROVED ON: 2-2-94
Register of Deeds, Section A, File Number
OAKLAND COUNTY REGISTER OF DEEDS
PEER GROUP COMMITTEE

	A	B	C	D	E	F	G	H	I	J	K	L	M
2	6		5		4		3		2		1		
3													
4	7		8		9		10		11		12		
5													
6	18		17		16		15		14		13		
7													
8	19		20		21		22		23		24		
9													
10	30		29		28		27		26		25		
11													
12	31		32		33		34		35		36		
13													

Bruce Antcliff November 5 93
I, _____, in a field survey on _____, 19_____, do hereby certify that under requirements of P.A. 74, Michigan P.A. of 1970, the corner points mentioned in lines 1 and 2 above were in conformance with regulations and rules therefore as required in the current manual of survey instructions of the United States Department of the Interior, Bureau of Land Management or by a decree of a Court of Law and/or that the corner points mentioned in lines 3, 4 and 5 above were in conformance with the rules of the Michigan Board of Land Surveyors or by a Decree of a Court of Law; established, re-established, monumented, re-monumented, recovered, found as expressed below:

NOTE: Not more than 4 corners, all in the same town and range, may be recorded on this certificate.

A. Description of original monument and accessories and/or subsequent restoration:

K-3	GLO Post	L.C.R.C. L. 6478, P. 616 (1975) 1/2" Iron Bar PK nail in D.E. pole - NW - 69.00' PK nail in 18" Maple - East - 33.06' PK nail in 12" Maple - SE - 45.16' PK nail in 20" Tw. Oak - SW - 60.20'	Survey: L. 6612, P. 706 Same as L.C.R.C. L. 6478, P. 616
-----	-------------	--	---

B. Description of corner evidence found and/or method applied in restoring or reestablishing corner:

K-3 Found 1/2" rebar at center line intersection of Hagerman Road and Gerst Road.
Checks the following witnesses:


L.C.R.C. L. 6478, P. 616 PK nail in D.E. Pole - NW - 69.00' PK Nail 18" Maple E 33.06 PK Nail 12" Maple SE 45.16	Survey: L. 6612, P. 706 Same as L.C.R.C. L. 6478, P. 616
---	---

C. Description of monument for corner and accessories established to perpetuate locating the position of the corner:

K-3 The selected location is accepted by the Contractor and is generally accepted by professional surveyors as the best available evidence of the position of the original corner.

Set 5/8" rebar with standard Oakland County cap.

P.K. Nail and Brass Tag in W Face P.Pole - S 20°W - 81.12'
P.K. Nail and Brass Tag in NE Face 18" Maple - S 21° E - 44.91'
P.K. Nail and Brass Tag in S Face 24" Maple - East - 33.65'
P.K. Nail and Brass Tag in E Face Tri. 14" Oak - N 2° W - 92.52'

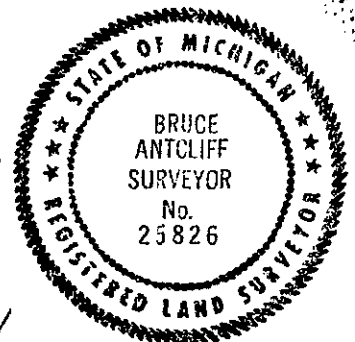

Signed by Bruce Antcliff
25826

Date 7-11-94

Surveyor's Michigan License No. _____