

MAY 1 8 1996

STATE OF MICHIGAN
COUNTY OF OCEANA
RECEIVED FEB 27 1996

LAND CORNER RECORDATION CERTIFICATE
Filing Requirement of Act 74, Mich. P.A. 1970

100687

'96 DEC 19 AM 11:11

For corners in Oceana Located In: _____ Corner Code # _____
(County)

1. Public Land Survey	T <u>14N</u> R <u>15W</u>	<u>G-9</u>
	T _____ R _____	_____
	T _____ R _____	_____
	T _____ R _____	_____
2. Property Controlling in Section	S _____ T _____ R _____	_____
	S _____ T _____ R _____	_____
3. Miscellaneous Property in Section	S _____ T _____ R _____	_____
	S _____ T _____ R _____	_____

J. Randolph Hepworth
REGISTER OF DEEDS

Register of Deeds Stamp & File Number

4. Lot No. _____, Recorded Plat _____
5. Private Claims _____

	A	B	C	D	E	F	G	H	I	J	K	L	M
2	6		5		4		3		2		1		
3													
4	7		8		9		10		11		12		
5													
6	18		17		16		15		14		13		
7													
8	19		20		21		22		23		24		
9													
10	30		29		28		27		26		25		
11													
12	31		32		33		34		35		36		
13													

I, J. Randolph Hepworth in a field survey on May 29, 1996, do hereby certify that under requirements of P.A. 74, Michigan P.A. of 1970, the corner points mentioned in lines 1 and 2 above were in conformance with regulations and rules therefore as required in the current manual of survey instructions of the United States Department of the Interior, Bureau of Land Management or by a decree of a Court of Law and/or that the corner points mentioned in lines 3, 4 and 5 above were in conformance with the rules of the Michigan Board of Professional Surveyors or by a Decree of a Court of Law; established, re-established, monumented, re-monumented, recovered, found as expressed below:

NOTE: Not more than 4 corners, all in the same town and range, may be recorded on this certificate.

A. Description of original monument and accessories and/or subsequent restoration:

G-9 Corner Common to Sections 21, 22, 27, & 28 T14N, R15W Newfield Township

GLO SET POST 15"Beech N36°W 18.5' 8"Beech S01°W 17.2'

Book A, Pg 577; H.C.Hawley, 1883, "Hole of 3' deep by 3 1/4" in dia. filled with brick, charcoal, crockery, and glass, etc. Beer bottle on top of Gov't Witness-Standing"

Book C, pg 2, F. Wetmore, 1900; "Old Corner set by Hawley See county records."

Book B, Pg 8; F. Wetmore, 1900; "Old Corner set by Hawley See county records."

Book C, Pg 160; H. Salisbury, Undated; Corner not referenced on this survey.

B. Description of corner evidence found and/or method applied in restoring or reestablishing corner.


I found a 1/2" iron in the surface at the centerline of E-W asphalt road and on good occupation lines to north and to south. On excavation and removal, I found the 1/2" iron to be a riser for a 1/2" Pipe. On further excavation, I found charcoal, brick, & pottery surrounding the pipe and iron. This corner is substantially as described by Hawley, 1883 who found the GLO corner.

This iron, pipe and charcoal were accepted as the best evidence of the corner and was accepted as being a careful and faithful re-establishment of the original corner. No evidence is known to me that would lead me to believe that the corner should be in another location. The irons were driven down and I placed a 4"x20" Harrison Cast Iron Monument, stamped "County Surveyor" & "26457" above at the found position.

C. Description of monument for corner and accessories established to perpetuate locating the position of the corner.

G-9	Corner Common to Sections 21, 22, 27 & 28	T14N, R15W	Newfield Township		
4"x20"	Harrison Cast Iron Monument, stamped "County Surveyor" & "26457"				
60d spk	E Face	Power Pole	354°az	33.19	EDM
PK nail	S Face	Power Pole	82°az	224.98	EDM
60d spk	SW Face	Cherry	296°az	156.72	EDM
60d spk	SE Face	4", 6", 8" W Oak	217°az	81.39	EDM
60d spk	S Face	Power Pole	279°az	223.58	EDM

Oceana County Remonumentation Peer Group Reviewed & Approved
Date: 11-7-96
JRH
J. Randolph Hepworth
Oceana County Surveyor

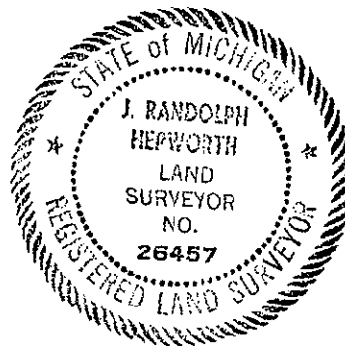

Signed by J. Randolph Hepworth
Surveyor's Michigan License No. 26457

Date December 5, 1996