

SURVEY &  
REMONUMENTATION

NOV 01 1999

LAND CORNER RECORDATION CERTIFICATE  
Filing Requirement of Act 74, Mich. P.A. 1970

SECTION

For corners in  
Osceola

(County)

Located In:

Corner Code #

1. Public Land Survey	T	19N	R	8W	L-5
	T		R		
	T		R		
	T		R		
2. Property Controlling in Section	S		T	R	
	S		T	R	
3. Miscellaneous Property in Sec.	S		T	R	
	S		T	R	

Register of Deeds Stamp & File Number

4. Lot No. \_\_\_\_\_, Recorded Plat \_\_\_\_\_  
5. Private Claims \_\_\_\_\_

I, Robert L. Wetherell, in a field survey on Aug 11, 1999 do hereby state that under requirements of P.A. 74, Michigan P.A. of 1970, the corner points mentioned in lines 1 and 2 above were in conformance with regulations and rules therefore as required in the current manual of survey instructions of the United States Department of the Interior, Bureau of Land Management or by a decree of a Court of Law and /or that the corner points mentioned in lines 3, 4 and 5 above were in conformance with the rules of the Michigan Board of Land Surveyors or by a Decree of a Court of Law; established, re-established, monumented, recovered, found as expressed below:

NOTE: Not more than 2 corners, all in the same town and range, may be recorded on this certificate.

A	B	C	D	E	F	G	H	I	J	K	L	M
1												
2	6		5		4		3		2		1	
3												
4	7		8		9		10		11		12	
5												
6	18		17		16		15		14		13	
7												
8	19		20		21		22		23		24	
9												
10	30		29		28		27		26		25	
11												
12	31		32		33		34		35		36	
13												

A. Description of original monument and accessories and/or subsequent restoration:

L-5 - N<sup>1</sup>/<sub>4</sub> Corner of Section 13, T19N, R8W

1838 - Sibley  
#1- 6" Beech N52W 22 Lks.  
#2 - 26" Sugar s30E 61 Lks

1891 - 1904 - A. Temple/F.Trumbull  
Remonumentation of T19N, R8W  
Set 3" Clay tiles

1942 - Hartwick Twp. Book  
"7 Stake & Iron"  
#3- F. Post South 24.7'.  
#4- Distance West 2626'.  
Distance East 2635'

B. Description of corner evidence found and/or method applied in restoring or reestablishing corner:

(SEE OVER FOR CONTINUATION OF "A")

I found McClung's Osceola County Monument and Tile

Condition of the accessories are as follows: #1 Gone, #2 Gone, #3Fd. Stump (24.7'), #4 Measured 2654.05', #5 Found in good condition, #6 Found in good condition, #7 Found in good condition, and #8 Found in good condition.


C. Description of monument for corner and accessories established to perpetuate locating the position of the corner:

I accept Osceola County Monument (1 1/2" Pipe with Osceola Remon Cap) and Tile as a substantial marker for the corner and is accepted it as a careful and faithful reestablishment of the position of the original corner.

I & C 13037 South 33.0' #5  
18" Ash (Nail on SW side) S60E 43.35 #7  
6" Sugar Maple (Nail on SE side) N30E 32.30' #8  
6" Sugar Maple (Nail on SW side) N28W 31.58'

Signed by Robert L. Wetherell  
Surveyor's Michigan License No. 24624

Date 8-26-99

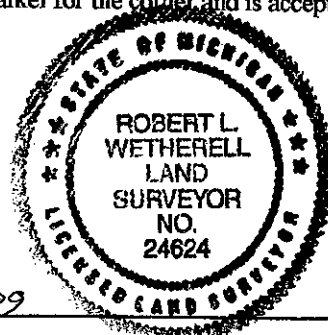

APPROVED LAND CORNER  
P.A. 345 OF 1990  
Osceola County

8-26-99

R.L.W.

CONTINUATION OF DESCRIPTION OF ORIGINAL MONUMENT AND ACCESSORIES AND/OR SUBSEQUENT RETORATION.

1997- McClung LS 13037

Survey Record

L. 622, Pg. 721

Fd. Tile

Set Osceola Co. Monument

#5 - Iron & Cap 13037 South 33'

#6 - 3" Iron wood N50W 7.95'

#7 - 18" White Ash S60E 43.50'

#8 - 6" Sugar Maple N30E 32.15'

*James Cleveland*

OSCEOLA COUNTY  
REGISTER OF DEEDS  
99 SEP - 3 AM 11:48

SURVEY &  
REMONUMENTATION

NOV 01 1999

SECTION