

DEC 21 2000

SECTION

LAND CORNER RECORDATION CERTIFICATE  
Filing Requirement of Act 74, Mich. P.A. 1970

For corners in

Oscoda  
(County)

Located In:

Corner Code #

- 1. Public Land Survey T 27N R 2E
- T \_\_\_\_\_ R \_\_\_\_\_
- T \_\_\_\_\_ R \_\_\_\_\_
- T \_\_\_\_\_ R \_\_\_\_\_
- 2. Property Controlling S \_\_\_\_\_ T \_\_\_\_\_ R \_\_\_\_\_
- in Section S \_\_\_\_\_ T \_\_\_\_\_ R \_\_\_\_\_
- 3. Miscellaneous S \_\_\_\_\_ T \_\_\_\_\_ R \_\_\_\_\_
- Property in Sec. S \_\_\_\_\_ T \_\_\_\_\_ R \_\_\_\_\_

C-2  
\_\_\_\_\_  
\_\_\_\_\_  
\_\_\_\_\_

- 4. Lot No. \_\_\_\_\_, Recorded Plat \_\_\_\_\_
- 5. Private Claims \_\_\_\_\_

I, Marvin E. Myers, in a field survey on June 8, 2000 do hereby state that under requirements of P.A. 74, Michigan P.A. of 1970, the corner points mentioned in lines 1 and 2 above were in conformance with regulations and rules therefore as required in the current manual of survey instructions of the United States Department of the Interior, Bureau of Land Management or by a decree of a Court of Law and /or that the corner points mentioned in lines 3, 4 and 5 above were in conformance with the rules of the Michigan Board of Land Surveyors or by a Decree of a Court of Law, established, re-established, monumented, recovered, found as expressed below:

**NOTE: Not more than 2 corners, all in the same town and range, may be recorded on this certificate.**

**A. Description of original monument and accessories and/or subsequent restoration.**

1/4 corner common to Sections 5 and 6, T27N, R2E

G.L.O. - 1839 William R. Coon D.S. Mon - Post Wit: 6" Spr. Pine S62°W 139 lks 4" Spr. Pine N78°W 203 lks	July 1982 L1, P273 K. Ostling 10068 Mon - D.N.R Monument by S.P. Wit: 8" Jackpine N75°W 26.4' 8" Red Oak S43°W 42.9'	Oct 1995 L195, P6825 Mitchell 28417 Mon - FND D.N.R. Monument & Post Wit: FND Nail SE SD 10" Oak S40°W 43.15' FND Nail W SD 13" Oak S12°W 49.08' Set SPK SE SD 3" S. Pine N50°E 23.58' Set SPK SE SD 4" S. Pine N20°W 27.3'
---	---	--

**B. Description of corner evidence found and/or method applied in restoring or reestablishing corner:**

1/4 corner common to Sections 5 and 6, T27N, R2E


Found Standard DNR Pipe & Cap (post is down); found nail SE side 10" Oak S40°W 43.15; found nail W. side 13" Oak S12°W 49.08; found spike SE side 3" S. Pine N50°E 23.58; found spike SE side 4" S. Pine N20°W 27.3'. Accepted DNR monument as a careful and faithful reestablishment of the position of the Government Corner.

**C. Description of monument for corner and accessories established to perpetuate locating the position of the corner:**

1/4 corner common to Sections 5 and 6, T27N, R2E

Mon - Standard DNR Pipe & Cap  
Wit: Nail SE side 10" Oak S40°W 43.15  
Nail W. side 13" Oak S12°W 49.08  
Spike SE side 3" S. Pine N50°E 23.58  
Spike SE side 4" S. Pine N20°W 27.3

APPROVED  
County Remonumentation  
Peer Review Group  
NCC  
27 JULY 00

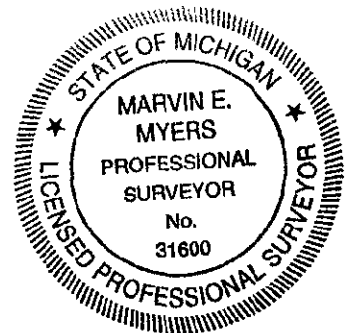

Signed by Marvin E. Myers  
Surveyor's Michigan License No. 31600

Date July 10, 2000

Liber 5 Pg 86

STATE OF MICHIGAN  
OSCODA COUNTY  
FILED

9 AUG 2000 3:28:41 PM

PATSY J. PETERS  
REGISTER OF DEEDS

Register of Deeds Stamp & File Number

	A	B	C	D	E	F	G	H	I	J	K	L	M
1													
2	6		5		4		3		2		1		
3													
4	7		8		9		10		11		12		
5													
6	18		17		16		15		14		13		
7													
8	19		20		21		22		23		24		
9													
10	30		29		28		27		26		25		
11													
12	31		32		33		34		35		36		
13													