

LAND CORNER RECORDATION CERTIFICATE

Filing Requirement of Act 74, Mich. PA 1970

For Corners In:

Oscoda (County)	Located In	Corner Code #
1. Public Land Survey	T <u>28N</u> R <u>3E</u>	<u>F-4</u>
	T _____ R _____	_____
2. Property Controlling in Section	S <u>9</u> T <u>28N</u> R <u>3E</u>	<u>5</u>
	S _____ T _____ R _____	_____
3. Miscellaneous Property in Section	S _____ T _____ R _____	_____
	S _____ T _____ R _____	_____


Register of Deeds Stamp & File Number

4. Lot No: _____ Recorded Plat: _____

5. Private Claims: _____

I, Carl T. Kiiskila, in a field survey on October 9, 2006 do hereby state that under requirements of PA 74, Michigan PA of 1970, the corner points mentioned in lines 1 and 2 above were in conformance with regulations and rules therefore as required in the current manual of survey instructions of the United States Department of the Interior, Bureau of Land Management or by a decree of a Court of Law and/or that the corner points mentioned in lines 3, 4 and 5 above were in conformance with the rules of the Michigan Board of Land Surveyors or by a Decree of a Court of Law, established, re-established, monumented, recovered, found as expressed below:

NOTE: Not more than 2 corners, all in the same town and range, may be recorded on this certificate.

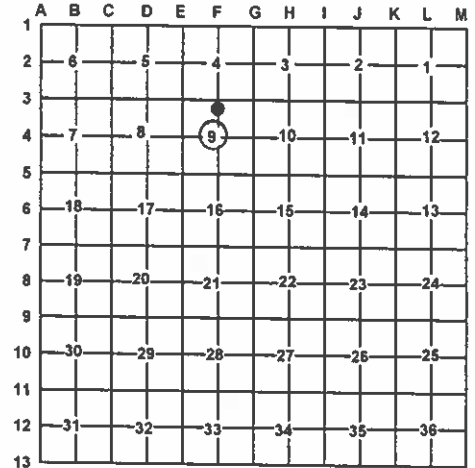

A. Description of original monument and accessories and/or subsequent restoration:

F-4 This corner position was not established during the original government survey.

5- This corner position was not established during the original government survey.

B. Description of corner evidence found and/or method applies in restoring or re-establishing corner:

F-4 Established the center of section 9 at the intersection of North-South and East-West quarter lines.

5- Established the Northeast corner of the Southeast quarter of the Northwest quarter of section 9 as per B.L.M. instructions for the subdivision of a section.

C. Description of monument for corner and accessories established to perpetuate locating the position of the corner:

F-4 Set 5/8" X 32" rerod with P.S. cap #33981

5- Set 5/8" X 32" rerod with P.S. cap #33981

Wit: 11" W. Pine	S32°E	12.03'
9" R. Pine	S27°W	22.85'
10" R. Pine	N44°E	21.50'
4" R. Pine	N42°W	19.49'
On E-W fence		

Wit: Twin 16" Maple	S04°W	30.02'
18" Oak	S36°E	42.48'
8"-16" Basswood clump	N67°E	11.02'
18" Maple	N22°W	52.63'

Signed by:

Carl T. Kiiskila

Date:

3-14-07

Surveyor's Michigan License No.:

33981

