

LAND CORNER RECORDATION CERTIFICATE

Filing Requirement of Act 74, Mich. PA 1970

For Corners In: <u>Oscoda</u> (County)	Located In	Corner Code #
1. Public Land Survey	T _____ R _____	_____
	T _____ R _____	_____
2. Property Controlling in Section	S <u>9</u> T <u>28N</u> R <u>3E</u>	<u>10</u>
	S _____ T _____ R _____	_____
3. Miscellaneous Property in Section	S _____ T _____ R _____	_____
	S _____ T _____ R _____	_____


Register of Deeds Stamp & File Number

4. Lot No: _____ Recorded Plat: _____

5. Private Claims: _____

I, Carl T. Kiiskila, in a field survey on September 13, 2006 do hereby state that under requirements of PA 74, Michigan PA of 1970, the corner points mentioned in lines 1 and 2 above were in conformance with regulations and rules therefore as required in the current manual of survey instructions of the United States Department of the Interior, Bureau of Land Management or by a decree of a Court of Law and/or that the corner points mentioned in lines 3, 4 and 5 above were in conformance with the rules of the Michigan Board of Land Surveyors or by a Decree of a Court of Law; established, re-established, monumented, recovered, found as expressed below:

NOTE: Not more than 2 corners, all in the same town and range, may be recorded on this certificate.

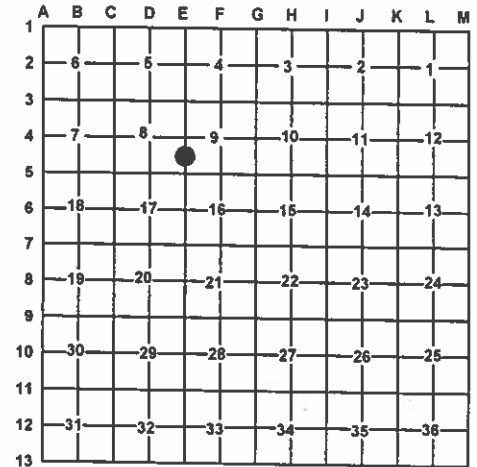

A. Description of original monument and accessories and/or subsequent restoration:
 10- 1972 Kenneth J. Ostling R.L.S.#10068 set a 1" x 24" pipe for this corner while doing a survey in section 8.

B. Description of corner evidence found and/or method applies in restoring or re-establishing corner:
 10- Found a 1" pipe 2.00' out of position for this corner.
 Re-established the Northwest corner of the Southwest quarter of the Southwest quarter of section 10 as per B.L.M. instructions for the subdivision of a section.

C. Description of monument for corner and accessories established to perpetuate locating the position of the corner:
 10- Set a 5/8" X 32" iron rod with P.S. cap #33981

Wit: 4" Red Pine	S16°W	36.14'
12" Red Pine	S63°E	32.56'
12" Oak	N25°W	30.71'
14" Red Pine	N52°W	37.37'
1" pipe	S50°E	2.00'

Signed by: Carl T. Kiiskila
 Surveyor's Michigan License No.: 33981

Date: 3-14-07

