

# LAND CORNER RECORDATION CERTIFICATE

Filing Requirement of Act 74, Mich. PA 1970

For Corners In: Otsego (County)	Located In	Corner Code #	
1. Public Land Survey	T <u>29N</u> R <u>1W</u>	<u>K-11</u>	
	T _____ R _____	_____	
2. Property Controlling in Section	S _____ T _____ R _____	_____	
	S _____ T _____ R _____	_____	
3. Miscellaneous Property in Section	S _____ T _____ R _____	_____	
	S _____ T _____ R _____	_____	


4. Lot No: \_\_\_\_\_ Recorded Plat: \_\_\_\_\_

5. Private Claims: \_\_\_\_\_

I, Carl T. Kiiskila, in a field survey on June 24, 2003 do hereby state that under requirements of PA 74, Michigan PA of 1970, the corner points mentioned in lines 1 and 2 above were in conformance with regulations and rules therefore as required in the current manual of survey instructions of the United States Department of the Interior, Bureau of Land Management or by a decree of a Court of Law and/or that the corner points mentioned in lines 3, 4 and 5 above were in conformance with the rules of the Michigan Board of Land Surveyors or by a Decree of a Court of Law; established, re-established, monumented, recovered, found as expressed below:

**NOTE: Not more than 2 corners, all in the same town and range, may be recorded on this certificate.**

Register of Deeds Stamp & File Number

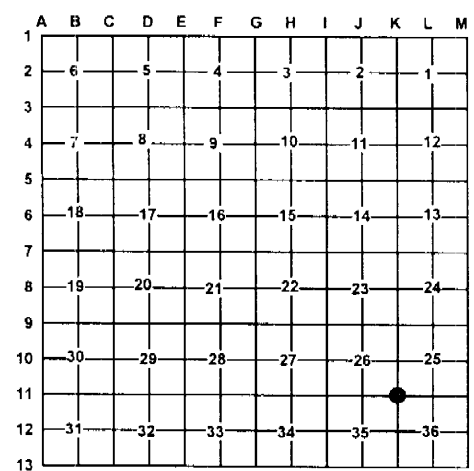

A. Description of original monument and accessories and/or subsequent restoration:

K-11 G.L.O. Harvey Mellen 1856 Set corner to sections 25,26,35 and 36. Wit: Aspen 8            N57°W    23 links Spruce Pine 10    S69°W    45 links	Liber 3, Page 248 S. Thorsen ,no date, 1/2" bar in corner Wit: 20" Norway    N01°W    82.55' 16" Norway        N66°W    48.5' 14" Norway        S33 1/2°E 37.6'
--	--

G.D. Henning's 1966 survey map shows he found and marked an original corner in 1941 type of monument not given.

Wit: 20" Norway	N01°W	82.55'
16" Norway	N66°W	48.5'
14" Norway	S33 1/2°E	37.6'

B. Description of corner evidence found and/or method applies in restoring or re-establishing corner:

K-11 Found 1/2" X 48" iron rod.

C. Description of monument for corner and accessories established to perpetuate locating the position of the corner:

K-11 Set County Monument

Wit: 12" R. Pine	S38°E	15.61'
24" R. Pine	S27°E	38.06'
16" W Pine	S38°W	27.23'
20" R. Pine	N61°W	49.01'
Carsonite Post	North	1'±



Signed by: Carl T. Kiiskila Date: 6-3-04

Surveyor's Michigan License No.: 33981