

REMONUMENTATION

APR 25 1995

COMMISSION

For corners in

OTSEGO COUNTY REMONUMENTATION
LAND CORNER RECORDATION CERTIFICATE
 Filing Requirement of Act 74, Mich. P.A. 1970
 ALSO ACT 345, PA 1990

LIBER 0004 PAGE 031

OTSEGO (County)	Located in:	Corner Code #
1. Public Land Survey	T 29N R 3W	K-3
	T _____ R _____	_____
	T _____ R _____	_____
	T _____ R _____	_____
2. Property Controlling in Section	S _____ T _____ R _____	_____
	S _____ T _____ R _____	_____
3. Miscellaneous Property in Sec.	S _____ T _____ R _____	_____
	S _____ T _____ R _____	_____
4. Lot No. _____, Recorded Plat _____		
5. Private Claims _____		

OTSEGO COUNTY
 MICHIGAN
 RECEIVED FOR RECORD

94 DEC 14 PM 4:04

LVELLYN M. PRATT
 CLERK / REGISTER OF DEEDS

Register of Deeds Stamp & File Number

I, James L. Schwandt, in a field survey on November 10, 19 94, do hereby certify that under requirements of P.A. 74, Michigan P.A. of 1970, the corner points mentioned in lines 1 and 2 above were in conformance with regulations and rules therefore as required in the current manual of survey instructions of the United States Department of the Interior, Bureau of Land Management or by a decree of a Court of Law and/or that the corner points mentioned in lines 3, 4 and 5 above were in conformance with the rules of the Michigan Board of Land Surveyors or by a Decree of a Court of Law, established, re-established, monumented, re-monumented, recovered, found as expressed below:

NOTE: Not more than 4 corners, all in the same town and range, may be recorded on this certificate.

	A	B	C	D	E	F	G	H	I	J	K	L	M
2	6	5	4	3	2	1							
3													
4	7	8	9	10	11	12							
5													
6	18	17	16	15	14	13							
7													
8	19	20	21	22	23	24							
9													
10	30	29	28	27	26	25							
11													
12	31	32	33	34	35	36							
13													

A. Description of original monument and accessories and/or subsequent restoration.

G.L.O. Harvey Mellen, 1857
 Re-established corner 1-2-11-12
 8" Beech S88°W 33 Lks.
 8" Beech S41°E 26 Lks.

Schweigert, 1952
 1/4" rod in corner
 4" Ironwood S70°W 24'
 16" Sugar N4°E 61.20'

C. Eugene Ostling #12026
 June 9, 1972, L1, P71
 Fd. 3/8" bar
 6" Maple S29°45'E 11.6'
 12" Birch S50°15'W 51.7'
 6" Maple N81°15'W 35.3'

Delamater, 1946
 Re-established corner and
 2 Beech witnesses


B. Description of corner evidence found and/or method applied in restoring or reestablishing corner:

Found 3/8" bar that fits with C.E. Ostling's 6" maple and 12" birch, as well as with DeLaMater's ironwood and sugar. Delamater re-established from G.L.O.

C. Description of monument for corner and accessories established to perpetuate locating the position of the corner:

K-3 Found 3/8" bar and replaced with O.C.M.
 O.C.M. is accepted as a careful and faithful perpetuation of the position of the original corner.

10" Maple S23°E 11.56' Found Nail
 18" Tri. Birch S55°W 51.13' Found Nail
 6" Beech S36°W 30.28' Found Nail
 8" Maple N75°W 33.15' Found Nail

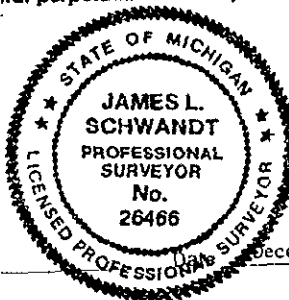

OTSEGO COUNTY REMONUMENTATION

Approved by the County Survey Peer Group, pursuant to Act 345, PA 1990.

DEC 13, 1994 Date [Signature] Chairman

Signed by James L. Schwandt
 Surveyor's Michigan License No. 26466

December 7, 1994