

**SURVEY & REMONUMENTATION**

DEC 01 1998

**SECTION**

Ottawa County Remonumentation  
**LAND CORNER RECORDATION CERTIFICATE**  
 Filing Requirement of Act 74, Mich. P.A. 1970

**RECORDED**  
 98 MAY 22 PM 4:06

For corners in

<u>Ottawa</u> (County)	Located In:	Corner Code #
1. Public Land Survey	T <u>5N</u> R <u>15W</u>	<u>A-9</u> (NW, 30) <u>Holland Twp.</u>
	T _____ R _____	_____
	T _____ R _____	_____
2. Property Controlling in Section	T <u>5N</u> R <u>16W</u>	<u>M-9</u>
	S _____ T _____ R _____	_____
	S _____ T _____ R _____	_____
3. Miscellaneous Property in Sec.	S _____ T _____ R _____	_____
	S _____ T _____ R _____	_____
4. Lot No. _____, Recorded Plat _____		
5. Private Claims _____		

*Sam Hill*  
 REGISTER OF DEEDS  
 OTTAWA COUNTY, MI

Register of Deeds Stamp & File Number

I, John C. Bueche, in a field survey on April 10, 19 98, do hereby certify that under requirements of P.A. 74, Michigan P.A. of 1970, the corner points mentioned in lines 1 and 2 above were in conformance with regulations and rules therefore as required in the current manual of survey instructions of the United States Department of the Interior, Bureau of Land Management or by a decree of a Court of Law and/or that the corner points mentioned in lines 3, 4 and 5 above were in conformance with the rules of the Michigan Board of Land Surveyors or by a Decree of a Court of Law; established, re-established, monumented, re-monumented, recovered, found as expressed below:

	A	B	C	D	E	F	G	H	I	J	K	L	M
2	6	5	4	3	2	1							
3													
4	7	8	9	10	11	12							
5													
6	18	17	16	15	14	13							
7													
8	19	20	21	22	23	24							
9													
10	30	29	28	27	26	25							
11													
12	31	32	33	34	35	36							
13													

**NOTE: Not more than 4 corners, all in the same town and range, may be recorded on this certificate.**

A. Description of original monument and accessories and/or subsequent restoration:

A-9 GLO	Remon. LCRC 2-73
Calvin Britain, 1832	M-9 Park Twp.
West boundary 10 North of post & set cor. to secs. 19 & 30	O.C. Remon. cap & bar in conc. in Mon. Box
Dogwood 4 N 76 E 29	O.C. Remon. Nail & Tag in S. side PP Az 279 27.53'
W. Oak 30 S 46 E 36	O.C. Remon. Nail & Tag in NW side Bluespruce Az 226 93.42'
	O.C. Remon. Nail & Tag in SW side Oak Az 94 28.16'
	O.C. Remon. Nail & Tag in S side PP Az 147 104.77'
	No statement, it is a common corner

Historically corner is being held as a common corner.

B. Description of corner evidence found and/or method applied in restoring or reestablishing corner: **OVER**


A-9 Found O.C. Mon. in Mon. Box	As per Remon. LCRC 2-73
	M-9 Park Twp.
	O.C. Remon. Nail & Tag in S. side PP Az 279 27.53'
	O.C. Remon. Nail & Tag in NW side Bluespruce Az 226 93.42'
	O.C. Remon. Nail & Tag in SW side Oak Az 94 28.16'
	O.C. Remon. Nail & Tag in S side PP Az 147 104.77'

Historically corner is being accepted and used by local surveyors as a common corner.

PA. 945 OTTAWA COUNTY

C. Description of monument for corner and accessories established to perpetuate locating the position of the corner:

A-9 Ottawa Co. Mon. in Mon. Box  
 Nail & Ottawa Co. Remon. Tag in N side PP (new pole) N 90° W 25.38'  
 Nail & Ottawa Co. Remon. Tag in NW side 14" Bluespruce S 46° W 93.40'  
 Nail & Ottawa Co. Remon. Tag in SW side 24" Oak S 40° E 104.74'  
 Nail & Ottawa Co. Remon. Tag in S side UP S 85° E 28.16'  
 Nail & Ottawa Co. Remon. Tag in W side UP S 10° W 141.58'  
 On C/L bit. N-S; C/L bit. E-W North 52'±; C/L bit. East, South 43'±

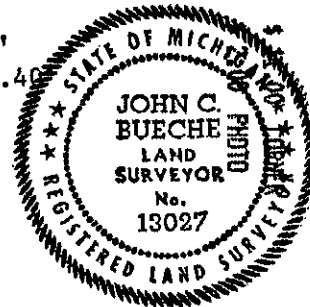

*John C. Bueche*  
 DEED APPROVED 4/20/98

Signed by John C. Bueche, P.S. 13027  
 Surveyor's Michigan License No. \_\_\_\_\_

Date 4-1-98

SURVEY &  
REMONUMENTATION

DEC 01 1998

A-9 SECTION  
PART A - continued

LCRC 1-807, Dec., 1972  
Fnd. iron pipe in mon. box  
No ties shown

LCRC 3-285, Aug., 1978  
Fnd. steel bar in mon. box  
PP W 27.65'  
GP NE 46.78'  
C/L st. sign SE 48.64'

LCRC 4-179, May, 1981  
Fnd. 5/8" iron rod in mon. box  
Replaced w/ 3/4" iron pipe in mon. box  
W 27.70' to PK in S side PP  
NE 46.72' to PK in S side PP  
SW 79.39' to PK in W side 16" Maple  
SE 64.15' to Nail in E GP

A-9 Peck, 1901  
Waverly stone in corner  
North 65 1/2' to C/L RR  
B. Oak 3" SE 1 1/2'  
Pine 6" N 53° W 23 1/2'

M-9 T&H Assoc., no date  
Conc. Mon. C/L pipe  
30" B. Oak NE 53.5'  
12" B. Oak SE 58.6'  
SW to NE cor. hse. fnd. 98.5'

A-9 Peck, 1900  
Fnd. stake & crockery  
Planted gas pipe  
E. 128.8' gas pipe  
SW 75.5' to 24" W. Oak  
E. 57.0' to 8" T. Oak

A-9 No date  
Conc. Mon., gas pipe, stone  
NW 36.4' to 3" W. Oak  
W 24.4' to PP  
NE 30" B. Oak 53.5'

A-9 Peck, 1900  
Stake & stone  
30" B. Oak NE 53.5'  
12" B. Oak SE 58.6'  
SW to NE cor. hse. 98.5'

