

COMMISSION

OTTAWA COUNTY REMONUMENTATION
LAND CORNER RECORDATION CERTIFICATE
Filing Requirement of Act 74, Mich. P.A. 1970

RECORDED

93 DEC 16 PM 1:00

For corners in

Ottawa (County)	Located In:	Corner Code=#
1. Public Land Survey	T 7N R 16W	I-7 S.E. Corner
	T R	Section 15
	T R	G.H. Twp.
	T R	
2. Property Controlling in Section	S T R	
	S T R	
3. Miscellaneous Property in Sec.	S T R	
	S T R	

Daphnia Caldwell
REGISTER OF DEEDS
OTTAWA COUNTY, MI

Register of Deeds Stamp & File Number

4. Lot No. _____, Recorded Plat _____
5. Private Claims _____

1. THOMAS E. JOINER in a field survey on 11-3-, 19 93, do hereby certify that under requirements of P.A. 74, Michigan P.A. of 1970, the corner points mentioned in lines 1 and 2 above were in conformance with regulations and rules therefore as required in the current manual of survey instructions of the United States Department of the Interior, Bureau of Land Management or by a decree of a Court of Law and/or that the corner points mentioned in lines 3, 4 and 5 above were in conformance with the rules of the Michigan Board of Land Surveyors or by a Decree of a Court of Law; established, re-established, monumented, re-monumented, recovered, found as expressed below:

A	B	C	D	E	F	G	H	I	J	K	L	M
2	6	5	4	3	2	1						
3												
4	7	8	9	10	11	12						
5												
6	18	17	16	15	14	13						
7												
8	19	20	21	22	23	24						
9												
10	30	29	28	27	26	25						
11												
12	31	32	33	34	35	36						
13												

NOTE: Not more than 4 corners, all in the same town and range, may be recorded on this certificate.


A. Description of original monument and accessories and/or subsequent restoration:

Found Iron - Found Spike Inside	Set Cast Iron Monument Inscribed "Section
Liber 1, Pg. 569 8-21-72	Corner" Liber 4, Pg. 70 6-5-80
5" Pine N.W. 55.64	5" Pine N.W. 55.64
16" Oak N.W. 39.39	16" Oak N.W. 39.39
15" Tw. Oak S.W. 48.77	15" Tw. Oak S.W. 48.77
C _L St. Sign S. 29.94	C _L St. Sign S. 29.94

B. Description of corner evidence found and/or method applied in restoring or reestablishing corner:

Found cast iron monument and accepted it as careful and faithful perpetuation of the original corner

15" Tw. Oak S.W. 48.77
C_L St. Sign S. 29.94

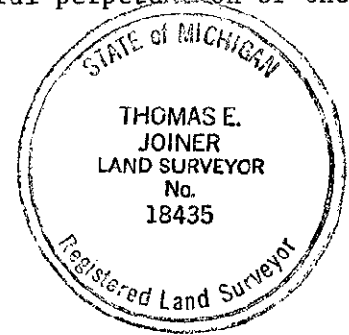

C. Description of monument for corner and accessories established to perpetuate locating the position of the corner:

Cast Iron Monument

O.C. Remon tag & nail West side of 46" Oak Bearing	North 23° East 90.41
O.C. Remon tag & nail West side of 7" White Pine	North 37° West 65.47
O.C. Remon tag & nail East side of 12" Oak Bearing	South 19° West 37.33
O.C. Remon tag & nail West side of 10" Oak Bearing	South 11° East 46.79

Signed by Thomas E. Joiner Date 11-19-93
Surveyor's Michigan License No. 18435