


LAND CORNER RECORDATION CERTIFICATE
Filing Requirement of Act 74, Mich. P.A. 1970
Ontonagon County Remonumentation Corner

Page 1 of 1
LC 5/123
JEN Rec. Date 09/03/98 Time 09:20
RECORDING FEE: 3.00

For corners in

- Ontonagon County Located in: Corner Code #
1. Public Land Survey T47N R38W K-3
2. Property Controlling in Section S T R
3. Miscellaneous Property in Sec. S T R
4. Lot No. , Recorded Plat
5. Private Claims

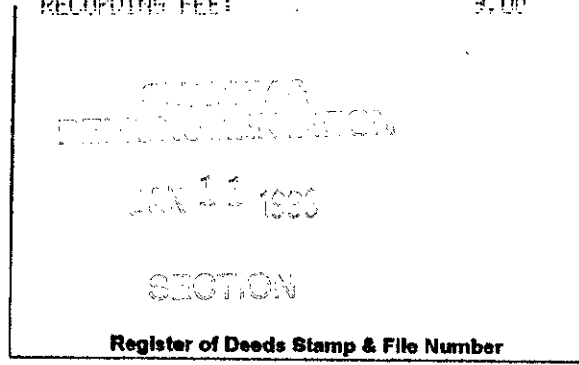

I, Joseph C. Domitrovich, in a field survey on July 21, 1998, do hereby state that under requirements of P.A. 74, Michigan P.A. of 1970, the corner points mentioned in lines 1 and 2 above were in conformance with regulations and rules therefore as required in the current manual of survey instructions of the United States Department of the Interior, Bureau of Land Management or by a decree of a Court of Law and /or that the corner points mentioned in lines 3, 4 and 5 above were in conformance with the rules of the Michigan Board of Land Surveyors or by a Decree of a Court of Law; established, re-established, monumented, recovered, found as expressed below:

NOTE: Not more than 2 corners, all in the same town and range, may be recorded on this certificate.

A. Description of original monument and accessories and/or subsequent restoration: (K-3) Corner Common to Sections 1, 2, 11 & 12, T47N, R38W

- 1851 - Zelotes B. Searls set a post.
10" White Pine S 62° W 20 links
12" White Pine N 14° E 9 links

I found no subsequent record.

B. Description of corner evidence found and/or method applied in restoring or reestablishing corner:

I found no remains of the original corner or accessories. The area of the Corner now falls in a four way intersection. I found a punched railroad spike 2" below pavement at the intersection of North-South Gardner Road and East-West "One Mile Road". Distances to Corners to West and South work well with GLO and occupation.

I accepted the railroad spike as the Section Corner.

Research on file with County Remonumentation Representative.


PEER GROUP APPROVAL
[Signature]
COUNTY REPRESENTATIVE
7-22-98

C. Description of monument for corner and accessories established to perpetuate locating the position of the corner:

Corner is center-punched railroad spike 2" below the pavement. I established 2 reference monuments (R.M. 1 and R.M. 2) to this corner. Both are 2 1/2" aluminum pipes with 3" diameter aluminum caps stamped: COUNTY REMONUMENTATION; T.47N, R.38W; R.M.; S.1, S.2, S.11, S.12; 1998; P.S. 37273. The reference monuments are also stamped with arrows and bearings and distances to the Section Corner. Steel sign rails have been placed behind the reference monuments.

Witnesses:

- Power Pole N 49° E 47.02' (existing nail)
R.M. 1 S 42° 33' 24" E 45.17'
R.M. 2 S 48° 00' 51" W 43.32'
6" Red Pine N 33° W 68.84'
N 1/4 Cor. Section 11 S 89° 51' 30" W 2624.91' (2627.46' GLO)
E 1/4 Cor. Section 11 S 00° 10' 56" E 2640.75' (2640' GLO)

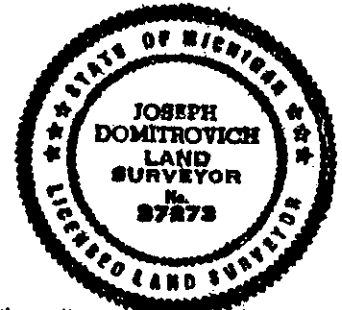

NOTE: Bearings to witness objects are magnetic. Distances are to a nail in side of the witness object unless noted.

Signed by [Signature]

Date 7/22/98

Surveyor's Michigan License No. 37273