

LAND CORNER RECORDATION CERTIFICATE
 Filing Requirement of Act 74, Mich. P.A. 1970

For corners in Ontonagon Located in: _____ Corner Code # _____
 (County)

1. Public Land Survey T 51N R 41W L7
 T _____ R _____
 T _____ R _____
 T _____ R _____

2. Property Controlling S _____ T _____ R _____
 in Section S _____ T _____ R _____

3. Miscellaneous S _____ T _____ R _____
 Property in Section S _____ T _____ R _____

4. Lot No. _____, Recorded Plat _____

5. Private Claims _____

**SURVEY &
 REMONUMENTATION**

MAY 22 1997

COMMISSION

Register of Deeds Stamp & File Number

One-quarter Section 13 and 24, T51N, R41W.

I, John R. Garske, in a field survey on July 17, 1996, do hereby certify that under requirements of P.A. 74, Michigan P.A. of 1970, the corner points mentioned in lines 1 and 2 above were in conformance with regulations and rules therefore as required in the current manual of survey instructions of the United States Department of the Interior, Bureau of Land Management or by a decree of a Court of Law and/or that the corner points mentioned in lines 3, 4 and 5 above were in conformance with the rules of the Michigan Board of Professional Surveyors or by a Decree of a Court of Law; established, re-established, monumented, re-monumented, recovered, found as expressed below:

NOTE: Not more than 4 corners, all in the same town and range, may be recorded on this certificate.

	A	B	C	D	E	F	G	H	I	J	K	L	M
2	6		5		4		3		2				
3													
4	7		8		9		10		11		12		
5													
6	18		17		16		15		14		13		
7													
8	19		20		21		22		23		24		
9													
10	30		29		28		27		26		25		
11													
12	31		32		33		34		35		36		
13													

A. Description of original monument and accessories and/or subsequent restoration:

In 1846 S.W. Higgins, U.S. Deputy Surveyor, set a wooden post from which a 12" hemlock bears S45°W - 5 links (3.30') and a 14" yellow birch - N10°E - 22 links (14.52').

B. Description of corner evidence found and/or method applied in restoring or reestablishing corner:

I set the corner at the center line intersection of an old north-south trail and an ancient east-west fence line. Measurements north, south and east were used to verify this position.


Record research on file.

C. Description of monument for corner and accessories established to perpetuate locating the position of the corner:

I set a 2 1/2" aluminum pipe with 3 1/4" aluminum cap stamped: County remonumentation, T51N, R41W, 1/4, S-13, S-24, 1996, R.L.S. 28410, from which I established the following reference objects:

- Steel trail with sign - S10°W - 2.17 feet
- 12" W. maple - S74°W - 35.41 feet
- 9" H. maple (in clump of 5) - S56°E - 102.89 feet
- 6" W. maple (in clump of 5) - N14°E - 83.61 feet

PEER GROUP AFFILIATION
Earl W. Applekamp 8-14-96
 COUNTY REPRESENTATIVE

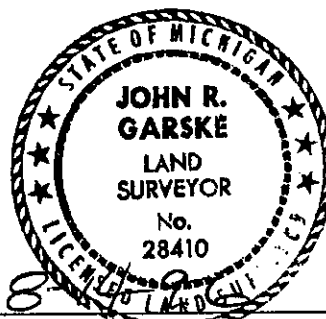

Signed by John R. Garske Date 8-14-96
 Surveyor's Michigan License No. 28410