

LAND CORNER RECORDATION CERTIFICATE  
Filing Requirement of Act 74, Mich. P.A. 1970

94 DEC 16 AM 9:40

LIBER NO. 1 PAGE NO. 486  
ESTHER LEE  
REGISTER OF DEEDS  
SANILAC CO., MICHIGAN

REMONUMENTATION & SURVEYING  
REMONUMENTATION  
APR 10 1995  
COMMISSION

For corners in Sanilac (County)

	Located In:	Corner Code #
1. Public Land Survey	T 10N R 14E	M - 13
	T _____ R _____	_____
	T _____ R _____	_____
	T _____ R _____	_____
2. Property Controlling in Section	S _____ T _____ R _____	_____
	S _____ T _____ R _____	_____
3. Miscellaneous Property in Sec.	S _____ T _____ R _____	_____
	S _____ T _____ R _____	_____
4. Lot No. _____, Recorded Plat _____		
5. Private Claims _____		

Register of Deeds Stamp & File Number

	A	B	C	D	E	F	G	H	I	J	K	L	M
2	6	5	4	3	2	1							
3													
4	7	8	9	10	11	12							
5													
6	18	17	16	15	14	13							
7													
8	19	20	21	22	23	24							
9													
10	30	29	28	27	26	25							
11													
12	31	32	33	34	35	36							
13													

I, John A Milletics, in a field survey on Dec 5, 1994, do hereby certify that under requirements of P.A. 74, Michigan P.A. of 1970, the corner points mentioned in lines 1 and 2 above were in conformance with regulations and rules therefore as required in the current manual of survey instructions of the United States Department of the Interior, Bureau of Land Management or by a decree of a Court of Law and/or that the corner points mentioned in lines 3, 4 and 5 above were in conformance with the rules of the Michigan Board of Land Surveyors or by a Decree of a Court of Law; established, re-established, monumented, re-monumented, recovered, found as expressed below:

NOTE: Not more than 4 corners, all in the same town and range, may be recorded on this certificate.

A. Description of original monument and accessories and/or subsequent restoration:

M - 13 GLO Notes

Does not say what was set, witnesses Ash 16 N 68 W 11, Ash 15 S 54½ E 32

Act 74 Form NONE

Act 132 Form Liber 4 Page 133

Unrecorded Surveys Found None

Road Comm NONE

Rain Comm NONE

B. Description of corner evidence found and/or method applied in restoring or reestablishing corner:

M - 13

SE Cor Section 36 T10N-R14E

Found 1/2" Iron Bar

Approved Peer Board Meeting

Dec 16, 1994 gm

C. Description of monument for corner and accessories established to perpetuate locating the position of the corner:

M -13

SE Cor Section 36 T10N-R14E


Found 1/2" Iron Bar

S30°E 41.70 to notch in south end of 72" CMP

N30°E 22.72 to notch in north end of 72" CMP

N45°W 14.48 to a nail in a guard rail post

S45°E 48.90 to a nail in a guard rail post

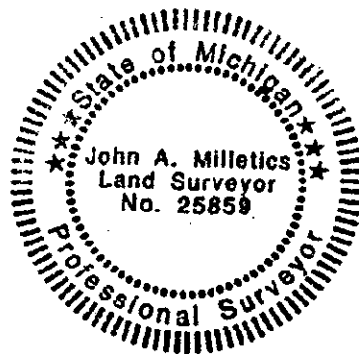

Signed by John A. Milletics

Date Dec 12, 1994

Surveyor's Michigan License No. 25859