

ST. CLAIR COUNTY, MICHIGAN OFFICIAL GOVERNMENT CORNER



LAND CORNER RECORDATION CERTIFICATE Filing Requirement of Act 74, Mich. P.A. 1970

RECEIVED
 REGISTER OF DEEDS
 ST. CLAIR COUNTY
 5 MS - 4 MID: 18

Located in: Kimball Twp. Corner Code # A-12

| | | |
|------------------------------------|--------------------------|---------------|
| 1. Public Land Survey | T <u>6N</u> R <u>16E</u> | <u>A-12</u> |
| | T _____ R _____ | _____ |
| | T _____ R _____ | _____ |
| | T _____ R _____ | _____ |
| 2. Property Controlling in Section | S _____ T _____ R _____ | <u>Sec. 2</u> |
| | S _____ T _____ R _____ | _____ |
| 3. Miscellaneous Property in Sec. | S _____ T _____ R _____ | _____ |
| | S _____ T _____ R _____ | _____ |

Register of Deeds Stamp & File Number

4. Lot No. _____, Recorded Plat _____
 5. Private Claims _____

| | A | B | C | D | E | F | G | H | I | J | K | L | M |
|----|----|---|----|---|----|---|----|---|----|---|----|---|---|
| 2 | 6 | | 5 | | 4 | | 3 | | 2 | | | | |
| 3 | | | | | | | | | | | | | |
| 4 | 7 | | 8 | | 9 | | 10 | | 11 | | 12 | | |
| 5 | | | | | | | | | | | | | |
| 6 | 18 | | 17 | | 16 | | 15 | | 14 | | 13 | | |
| 7 | | | | | | | | | | | | | |
| 8 | 19 | | 20 | | 21 | | 22 | | 23 | | 24 | | |
| 9 | | | | | | | | | | | | | |
| 10 | 30 | | 29 | | 28 | | 27 | | 26 | | 25 | | |
| 11 | | | | | | | | | | | | | |
| 12 | 31 | | 32 | | 33 | | 34 | | 35 | | 36 | | |
| 13 | | | | | | | | | | | | | |

I, Daniel E. Johnson in a field survey on May 11, 1995 do hereby certify that under requirements of P.A. 74, Michigan P.A. of 1970, the corner points mentioned in lines 1 and 2 above were in conformance with regulations and rules therefore as required in the current manual of survey instructions of the United States Department of the Interior, Bureau of Land Management or by a decree of a Court of Law and/or that the corner points mentioned in lines 3, 4 and 5 above were in conformance with the rules of the Michigan Board of Land Surveyors or by a Decree of a Court of Law; established, re-established, monumented, re-monumented, recovered, found as expressed below:

NOTE: Not more than 1 corner, may be recorded on this certificate.

A. Description of original monument and accessories and/or subsequent restoration:

1. No gov't Corner set for this location.
 Found "T" iron with cap LLS 31596
 Reference certificate filed L.7 P.65


STATE PLAIN COORDINATES

N. _____
 E. _____

B. Description of corner evidence found and/or method applied in restoring or reestablishing corner:

$\frac{1}{4}$ corner was properly proportioned between section corners in Sec. _____

Note: Certificate filed in L6 P.67 and L4 P.382 were incorrectly

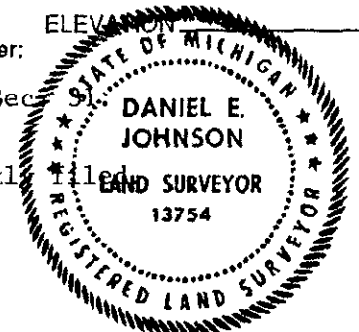

C. Description of monument for corner and accessories established to perpetuate locating the position of the corner:
 Set 2" dia. aluminum cap inscribed "St. Clair County Official Corner" with magnet on a "T" iron with cap (LLS 31596).
 E.N.E. 26.20 ft. Set PK Nail and County Tag in fence post.N.W. 35.38 ft. set PK Nail and county tag in fence post.
 Northerly 24.35 ft. to East $\frac{1}{4}$ corner of Sec. 36, T.6N., R.15E.

Signed by Daniel E. Johnson Date May 11, 1995
 Surveyor's Michigan License No. 13754

PA 345-1990
 PEER COMMITTEE

APPROVED AS AN OFFICIAL GOVERNMENT CORNER BY ST. CLAIR COUNTY:

APPROVED 11-30-93 *Jan B*

Signed By: Daniel E. Johnson Date 7-31-95
 St. Clair County Land Surveyor
 13754

LIBER 008 PAGE 134

Surveyor's Michigan License No. _____