

MICHIGAN
DEPARTMENT OF CONSERVATION
FORESTRY DIVISION

LAND CORNER RECORD

T. 45-46N N.R. 13W


Schoolcraft COUNTY

DESCRIPTION OF CORNER West 1/16 corner bet. Secs. 3-34

CORNER MONUMENT 1" pipe with 4" aluminum cap

DATE MONUMENT PLACED AND WITNESSED 9-16-70

WITNESSES TO CORNER..... 6" Tamarack (W 1/16 BT) N45°W 5.0'

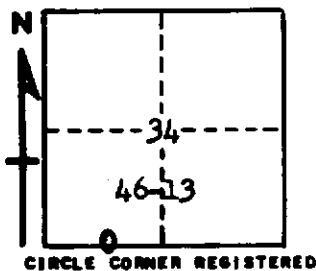

6" Tamarack (W 1/16 BT) S77°E 2.4'

AND

CIRCLE CORNER REGISTERED

DESCRIPTION IN DETAIL AS TO HOW CORNER WAS LOCATED AND IDENTIFIED OR RESTORED.

This corner placed midway bet. Sec. Cor. to west and $\frac{1}{4}$ Cor. to East.

SURVEYOR'S SEAL

Billy D. Buckler
SIGNED Billy D. Buckler DATE 9-16-70
REGISTERED LAND SURVEYOR