

JAN 14 1998

VAN BUREN COUNTY REMONUMENTATION LAND CORNER RECORDATION CERTIFICATE Filing Requirement of Act 74, Mich. P.A. 1970

DEC 16 12 00 PM '97

Mark A. Smith VAN BUREN COUNTY SURVEYOR

SECTION

For corners in VAN BUREN COUNTY Located in: COLUMBIA TWP. S 1/4 POST SEC 6 T1S,R15W N 1/4 POST SEC 7 T1S,R15W Corner ID #

- 1. Public Land Survey T 1S R 15W B-3
2. Property Controlling in Section S T R
3. Miscellaneous Property in Sec. S T R
4. Lot No. Recorded Plat
5. Private Claims

Lib 5 Page 41 Register of Deeds Stamp & File Number

Grid table with columns A-L and rows 2-13. Cell (3,7) contains a black dot.

Ratified by Peer Group in accordance with P.A. 345 of 1990 Van Buren County Surveyor

Date D. R. G. 12/16/97

I, Alan Bartlett in a field survey on November 25 1997 hereby certify that under requirements of P.A. 74, Michigan P.A. of 1970, the corner points mentioned in lines 1 and 2 above were in conformance with regulations and rules therefore as required in the current manual of survey instructions of the United States Department of the Interior, Bureau of Land Management or by a decree of a Court of Law and/or that the corner points mentioned in lines 3, 4 and 5 above were in conformance with the rules of the Michigan Board of Land Surveyors or by a Decree of a Court of Law; established, re-established, monumented, re-monumented, recovered, found as expressed below:

NOTE: Not more than 4 corners, all in the same town and range, may be recorded on this certificate.

A. Description of original monument and accessories and/or subsequent restoration:

- 2/8/1830 GLO 75.57 INTERSECTED WEST BOUNDARY 15 LKS N. OF POST AT INTERSECTION CORNER TO SECTION 6 & 7 WITNESSES HEMLOCK 11" EAST 18 LKS MAPLE 16" S10°E 27 LKS
10/15/1901 W.H. GOSS DEPUTY COUNTY SURVEYOR BOOK 1 PAGE 88 FOUND STAKE (NO WITNESSES)
11/17/1997 LANDMARK TECH. ALAN BARTLETT RLS#25988 FOUND REBAR AT INTERSECTION OF 57TH AND 4TH ST. 3' WEST OF CENTER LINE IN GRAVEL ROAD. WITNESSES N90°E 41.13' TOP THREADED BOLT SOUTH SIDE OF 4" PIPE FENCE COR. S35°E 30.18' CL STREET SIGN PIPE 2" DIA S50°W 36.66' SET NAIL IN SE SIDE OF P.P. N50°W 39.61' SET NAIL IN SW SIDE OF P.P.

B. Description of corner evidence found and/or method applied in restoring or reestablishing corner:


FOUND REBAR @ INTERSECTION OF 57TH AND 4TH 3' WEST OF CENTER LINE OF GRAVEL ROAD. VERIFIED CORNER LOCATION USING EXISTING WITNESSES. THIS GOVERNMENT MONUMENT WAS RESTORED WITH APPROVAL OF THE VAN BUREN COUNTY REMONUMENTATION PEER GROUP OF SURVEYORS, NOVEMBER 19 1997.

C. Description of monument for corner and accessories established to perpetuate locating the position of the corner:

SET 3 1/2" HARRISON MONUMENT AT INTERSECTION OF 57TH AND 4TH, 3' WEST OF CENTERLINE OF 57TH 1.2' BENEATH SURFACE OF GRAVEL ROAD.

- WITNESSES N90°E 41.13' TOP THREADED BOLT SOUTH SIDE OF 4" PIPE FENCE CORNER S35°E 30.18' CENTER LINE OF STOP SIGN 2" DIAMETER POST S50°W 36.66' SET NAIL IN SE SIDE OF POWER POLE N50°W 39.61' SET NAIL IN SW SIDE OF POWER POLE

CORNER IS ACCEPTED AS THE BEST AVAILABLE EVIDENCE OF THE POSITION OF THE ORIGINAL CORNER.

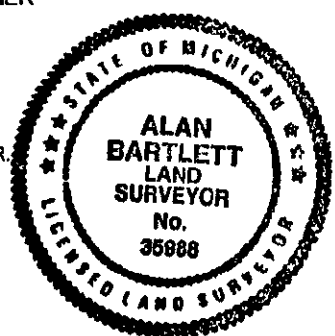

Signed by Alan K. Bartlett Date Dec. 15, 1997 Michigan License No. 35988

Surveyor's

B-3 T1S, R15W

LIBER 5 PAGE 60

2/8/1830 75.57 Intersected West Boundary 15 lns N of Post. Set Post at intersection Corner to Section 6 and 7.

		Witnesses	
Hemlock	11"	East	18 lks
Maple	16"	S10°E	27 lks

10/15/1901 W.H. Goss Deputy County Surveyor

Found Stake

No Witnesses

10/1901

Set Oak Stake midway between Section Corner

10/1901 Book 1, Page 88 W.H.Goss

Located this corner midway between "1" and "4" on Town Line 35 ½ lks. (23.43') South from Geneva Quarter Post. Set Oak Stake 39.99 ½ North and South (2639.67')