

APR 24 1995

COMMISSION

1994 Alcona County Remonumentation Corner

LAND CORNER RECORDATION CERTIFICATE
Filing Requirement of Act 74, Mich. P.A. 1970

Alcona County
Remonumentation
Liber 1 Page 103

RECORDED

For corners in

Alcona
(County)

Located In:

Corner Code

1. Public Land Survey T 25N R 9E
T R
T R
T R
2. Property Controlling S T R
in Section S T R
3. Miscellaneous S T R
Property in Sec. S T R

I-8

APPROVED LAND CORNER
P.A. 345 of 1990
ALCONA COUNTY
Date 12-21-94
County Rep E.T.L.

DEC 21 2 09 PM '94

David A. Guthrie
REGISTER OF DEEDS
ALCONA COUNTY, MICHIGAN

Register of Deeds Stamp & File Number

4. Lot No. , Recorded Plat
5. Private Claims

David B. Guthrie in a field survey on October 24, 19 94, do hereby certify that under requirements of P.A. 74, Michigan P.A. of 1970, the corner points mentioned in lines 1 and 2 above were in conformance with regulations and rules therefore as required in the current manual of survey instructions of the United States Department of the Interior, Bureau of Land Management or by a decree of a Court of Law and/or that the corner points mentioned in lines 3, 4 and 5 above were in conformance with the rules of the Michigan Board of Land Surveyors or by a Decree of a Court of Law; established, re-established, monumented, re-monumented, recovered, found as expressed below:

NOTE: Not more than 4 corners, all in the same town and range, may be recorded on this certificate.

A. Description of original monument and accessories and/or subsequent restoration:

1843: G.L.O. Survey by Mullett & Burt - Set Post and Referenced
Fir 6 - N12W - 16 / Hem 8 - S23E - 19

1941: Survey by R.J. Cooke - Plat of Cedar Haven

1950: Survey by Clarence F. Aikman - Plat of Huron-Cedar Lakes Sub. No. 4

1993: Survey by Thomas L. Fabis - Found Concrete Monument, Referenced.

B. Description of corner evidence found and/or method applied in restoring or reestablishing corner:


1994: Found Concrete Monument, verified 1993 Thomas L. Fabis, references.

C. Description of monument for corner and accessories established to perpetuate locating the position of the corner:

1994: Capped Concrete Monument with a 3" Aluminum Cap stamped to identify the Corner.

Referenced -

- N28°E - 7" Cedar - 10.70 feet
- N50°W - 5" Ash - 3.35 feet
- S25°E - 7" Cedar - 11.32 feet
- West - 15" White Pine - 32.05 feet

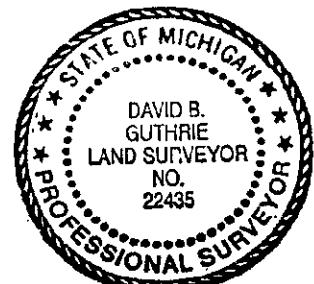

Signed by

D.B. Guthrie

Date

Dec. 21, 1994

Surveyor's Michigan License No. 22435