

LAND CORNER RECORDATION CERTIFICATE
Filing Requirement of Act 74, Mich. P.A. 1970

SECTION

For corners in

Alcona

(County)

Located In:

Corner Code #

1. Public Land Survey

T 26NR 06E

H-5

T R

T R

T R

2. Property Controlling
in Section

S

T R

S

T R

3. Miscellaneous
Property in Sec.

S

T R

S

T R

4. Lot No. , Recorded Plat

5. Private Claims

I, Wayne T. Lewis, in a field survey on 9-24, 19 99 do hereby state that under requirements of P.A. 74, Michigan P.A. of 1970, the corner points mentioned in lines 1 and 2 above were in conformance with regulations and rules therefore as required in the current manual of survey instructions of the United States Department of the Interior, Bureau of Land Management or by a decree of a Court of Law and/or that the corner points mentioned in lines 3, 4 and 5 above were in conformance with the rules of the Michigan Board of Land Surveyors or by a Decree of a Court of Law; established, re-established, monumented, recovered, found as expressed below:

NOTE: Not more than 2 corners, all in the same town and range, may be recorded on this certificate.

A. Description of original monument and accessories and/or subsequent restoration:

1846: James Mullet set post and witnessed

Unknown Date: MDOT Plans: no monumentation given, witnessed

1987: S. S. Barnett, P.S., found 1" axle shaft in mon. box and recorded survey (L213, P972) and LCRC (L1, P270) and witnessed

1988: D. B. Guthrie, P.S., found iron stake in mon. box, no witnesses given

1997: J. F. Oliver, P.S., fd pavement box 6.62' S. of C/L & recorded survey (L306, P604), no monumentation or witnesses given

B. Description of corner evidence found and/or method applied in restoring or reestablishing corner:

Found 1" iron rod in mon. box, 7' South of E/W C/L

This corner position is accepted as a careful and faithful perpetuation of the position of the original corner.

APPROVED LAND CORNER
P A 345 of 1990
ALCONA COUNTY
Date: 11/30/99
County Rep W.T. Lewis

C. Description of monument for corner and accessories established to perpetuate locating the position of the corner:

1999: Placed 3" Alcona County cap, stamped to identify the corner, on 1/2" rered driven next to iron rod

Witnesses:


S 45° W 79.05' 15" Aspen w/bearing tree tag and spike

S 20° E 57.43' 18" Red Pine w/bearing tree tag and spike

N 30° E 68.43' 15" Hemlock w/bearing tree tag and spike and MSHD tag

North 81.70' ROW monument

N 30° W 112.65' 18" Birch w/mshd tag

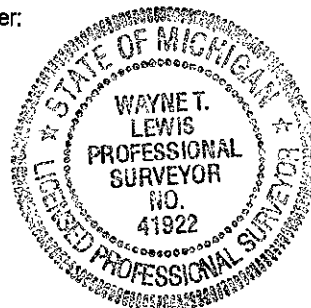

Signed by Wayne T. Lewis

Date December 16, 1999

Surveyor's Michigan License No. 41922