

SURVEY & REMONUMENTATION

1998 ALCONA COUNTY REMONUMENTATION CORNER

FEB 19 1999

LAND CORNER RECORDATION CERTIFICATE

Filing Requirement of Act 74, Mich. P.A. 1970

0  
Filed for Record in  
ALCONA COUNTY MICHIGAN  
DORIS A GAUTHIER  
On 12-17-1998 At 05:35:08 pm.  
LAND CORNER 9.00

For corners in  
SECTION  
(County)

Located In:

Corner Code #

1. Public Land Survey T 28N R 9E I-9  
T R Alcona Twp.  
T R  
T R  
T R
2. Property Controlling S T R  
in Section S T R  
3. Miscellaneous S T R  
Property in Section S T R

Alcona County  
Remonumentation  
Liberal  
APPROVED LAND CORNER  
P A 345 of 1990  
ALCONA COUNTY  
Date 10/28/98  
County Rep J. P. R. En  
Register of Deeds Stamp & File Number

4. Lot No. , Recorded Plat  
5. Private Claims

I, Thomas L. Fabis, in a field survey on May 27, 19 98, do hereby certify that under requirements of P.A. 74, Michigan P.A. of 1970, the corner points mentioned in lines 1 and 2 above were in conformance with regulations and rules therefore as required in the current manual of survey instructions of the United States Department of the Interior, Bureau of Land Management or by a decree of a Court of Law and/or that the corner points mentioned in lines 3, 4 and 5 above were in conformance with the rules of the Michigan Board of Professional Surveyors or by a Decree of a Court of Law; established, re-established, monumented, re-monumented, recovered, found as expressed below:

NOTE: Not more than 4 corners, all in the same town and range, may be recorded on this certificate.

A. Description of original monument and accessories and/or subsequent restoration:

- 1840: G.L.O. Survey Thos. Pattison Set post & referenced: Hem 12 S37W 6, Do 18 N30E 7.  
1968: Survey L.205 P.95A James Scott Measures to I-8.  
1975: LCRC L.1 P.24 James Scott Ex. Conc. Mon. previously set in 1946.  
1985: LCRC L.1 P.166 & Survey L.200 P.826 David Guthrie Fnd. Conc. Mon. & replaced with Brass capped Forest Service Conc. Mon. & referenced.  
1986: R.S.Scott Survey W.O.1-1433 David Guthrie Fnd. Conc. Mon.  
1988: Survey L.224 P.835 & 837 Robert Mitchell Fnd. U.S.F.S. Mon.  
1992: Survey Job No.22-289-4569-265592 Duane MacNeill Fnd. Mon. w/Brass cap.  
1996: Survey W.O.1-1923 David Guthrie Ex. 5" sq. Conc. Monument.  
1997: Survey John Oliver Fnd. conc. mon.

B. Description of corner evidence found and/or method applied in restoring or reestablishing corner:

- 1998: Found Forest Service Conc. Mon. with brass cap 22 feet North of LaVarne Rd. centerline (Bit. surface) and 4 feet East of LaLonde Rd. (gravel surface).  
Found two existing witnesses:  
Shiner in 18" Ash N20E 56.74'  
Nail in 8" Ash S30E 65.49'  
Also, found a 1" pipe buried 2.5 feet deep below road surface on line with gravel road centerline to the South and 8 feet South of LaVargne Rd. centerline.


The position of the Forest Service Conc. Mon. is compatible with local and Forest Service surveys and is accepted as a careful and faithful perpetuation of the position of the original corner.

C. Description of monument for corner and accessories established to perpetuate locating the position of the corner:

- 1998: Existing Forest Service Concrete Monument. Witnesses are:  
Shiner in 18" Ash N20E 56.74'  
Nail in 8" Ash S30E 65.49'  
Set tag in 26" Ash N30W 90.58'  
Set tag in 6" Ash S10E 58.35'

Signed by Thomas L Fabis

Surveyor's Michigan License No. 31591

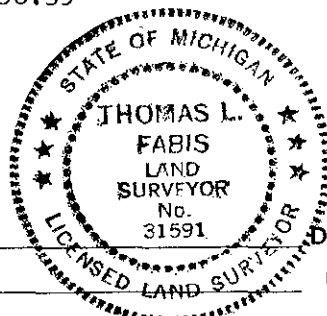

Date December 11, 1998