

LAND CORNER RECORDATION CERTIFICATE
Filing Requirement of Act 74, Mich. P.A. 1970

For corners in
Alger

Located in:

Corner Code #

(County)

1. Public Land Survey

T 46N R 17W I9
T R
T R
T R
T R
S T R
S T R
S T R
S T R

2. Property Controlling
in Section

3. Miscellaneous
Property in Sec.

Register of Deeds Stamp & File Number

4. Lot No. , Recorded Plat

5. Private Claims

Oct 30 2002

I, Stephan J. Szyszkoski, in a field survey on _____, 19 d o hereby state that under requirements of P.A. 74, Michigan P.A. of 1970, the corner points mentioned in lines 1 and 2 above were in conformance with regulations and rules therefore as required in the current manual of survey instructions of the United States Department of the Interior, Bureau of Land Management or by a decree of a Court of Law and /or that the corner points mentioned in lines 3, 4 and 5 above were in conformance with the rules of the Michigan Board of Land Surveyors or by a Decree of a Court of Law; established, re-established, monumented, recovered, found as expressed below:

NOTE: Not more than 2 corners, all in the same town and range, may be recorded on this certificate.

	A	B	C	D	E	F	G	H	I	J	K	L	M
1													
2	6		5		4		3		2		1		
3													
4	7		8		9		10		11		12		
5													
6	18		17		16		15		14		13		
7													
8	19		20		21		22		23		24		
9													
10	30		29		28		27		26		25		
11													
12	31		32		33		34		35		36		
13													


A. Description of original monument and accessories and/or subsequent restoration:
(19) Corner common to Sections 22-23-26-27. Remonumented in 1953 by MI Dept. of Conservation surveyor Dean C. DeLaMater, RLS: This corner was found by Forestry Division survey crew, while making a partial resurvey of this township. One original B.T. still in place, in poor condition. Description of corner monument: 1' pipe with 4" brass cap. Witnesses: 4" Spruce S10W 23 links.

B. Description of corner evidence found and/or method applied in restoring or reestablishing corner:

(19) Found the 1953 monument as described, in good condition, and at record bearing and distance from the 1953 Spruce NBT, now a rotting 2' high stub with measuring notch visible. The original BT (Cedar 8 N70W 9 links) is now a rotted stump bottom at record bearing and distance. Left the monument in place and made new witnesses as described below.

C. Description of monument for corner and accessories established to perpetuate locating the position of the corner:

(19) Found 1" ID 1. pipe with 4" brass HI
Dept. of Conservation cap. Blazed,
scribed, and set measuring nails in:
8" Cedar N75W 16.75' "S22 NBT"
10" Cedar N05W 11.0' do
12' Cedar N68E 11.9' "S23 NBT"
10" Tamarack S15E 19.8' "S26 NBT"
Bearings are magnetic. Distances to
nail with tag.

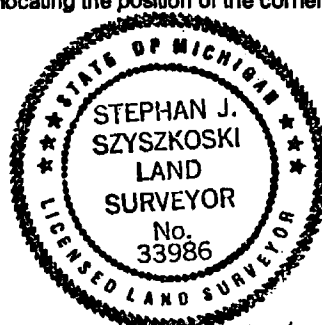

Signed by Stephan J. Szyszkoski
Surveyor's Michigan License No. 33986

Date 12/5/02

For the Michigan Department of Natural Resources - Office of Property Management

FORM APPROVED BY MICHIGAN STATE BOARD OF PROFESSIONAL SURVEYORS, JAN. 28, 1971
REVISED MAY 14, 1975
REVISED JAN. 1983
REVISED OCT., 1995