

CRF - 12-24-1999

DEC 27 1999

Approved by Alger County  
Land Survey Remonumentation  
Peer Group Under Act 345 of  
P.A. of 1990 On 12-8-1999

Gerald W. Carlson  
Chairman

For corners in **SECTION**

**LAND CORNER RECORDATION CERTIFICATE**  
Filing Requirement of Act 74, Mich. P.A. 1970

05-176

Alger	Located In:	Corner Code #
(County)		
1. Public Land Survey	T 48N R 15W	M1 ✓
	T 48N R 14W	A1
	T 49N R 14W	A13
	T 49N R 15W	M13
2. Property Controlling	S T R	
in Section	S T R	
3. Miscellaneous	S T R	
Property in Section	S T R	

FILED  
TIME 1:30 p.m.

DEC 15 1999

DONALD W. KINNUNEN  
REGISTER OF DEEDS  
ALGER COUNTY, MI  
Register of Deeds Stamp & File Number

4. Lot No. \_\_\_\_\_, Recorded Plat \_\_\_\_\_  
5. Private Claims \_\_\_\_\_

I, Robert L. Jamros, in a field survey on September 17, 1999, 19\_\_\_\_\_, do hereby state that under requirements of P.A. 74, Michigan P.A. of 1970, the corner points mentioned in lines 1 and 2 above were in conformance with regulations and rules therefore as required in the current manual of survey instructions of the United States Department of the Interior, Bureau of Land Management or by a decree of a Court of Law and/or that the corner points mentioned in lines 3, 4 and 5 above were in conformance with the rules of the Michigan Board of Land Surveyors or by a Decree of a Court of Law; established, re-established, monumented, recovered, found as expressed below:

NOTE: Not more than 2 corners, all in the same town and range, may be recorded on this certificate.

A	B	C	D	E	F	G	H	I	J	K	L	M
2	6	5	4	3	2	1						
3												
4	7	8	9	10	11	12						
5												
6	13	17	16	15	14	13						
7												
8	19	20	21	22	23	24						
9												
10	30	29	28	27	26	25						
11												
12	31	32	33	34	35	36						
13												

A. Description of original monument and accessories and/or subsequent restoration:


M1: PLS \* John Burt, OS, 1841. \* Set post corner of Township 48 and 49 North, Ranges 14 and 15 West. \* Beech 12", S.50 W., 31 links. \* Sugar 10", N.63 E., 47 links. \*\*\*\*\* C.C.I.Co., Land Corner Record. \* Ray J. Brotherton, RLS, 1949. \* Set an iron truck axle from original BT, Beech stump. \* Original Maple BT remains noted. \* 16" Sugar, S.05 W., 25.5 links. \* 3" Sugar, N.40 W., 30.5 links. \* Unrecorded. \*\*\*\*\* C.C.I. Co., Land Corner Record. \* T.J. McLaren, 1967. \* Found truck axle. \* R.Maple 7", S.76 W., 7.0 feet. \* R.Maple 6", N.68 E., 7.7 feet. \* Unrecorded. \*\*\*\*\* Robert E. Schmeling, RLS, 1980. \* Found iron truck axle and accessories as noted in the 1949 and 1960 unrecorded reports. \* Set 1" iron pipe with brass cap next to truck axle. \* H.Maple 7", N.10 E., 8.0 feet (S36 NBT). \* Beech 18", N.72 E., 45.9 feet (S31 NBT). \* S.Maple 10", S.03 E., 25.2 feet (S6 NBT). \* S.Maple 9", S.42 W., 49.5 feet (S1 NBT). \* Liber 1, Page 368, Alger County Corner Records. \*\*\*\*\* No other subsequent restoration of record.

B. Description of corner evidence found and/or method applied in restoring or reestablishing corner:

M1: Located corner search area by calculated position and standard field survey methods. Found 1" iron pipe with brass cap and an iron truck axle. Also found 1 BT of the 1967 report and 3 BT's of the 1980 report. All other BT's destroyed in logging operations. Renewed remaining existing BT's. Existing corner monument as found is accepted as a careful and faithful perpetuation of the position of the original corner.

C. Description of monument for corner and accessories established to perpetuate locating the position of the corner:

M1: Existing 1" iron pipe with brass cap. \* Renewed existing references with BT signs and paint. \* Set PK nails with aluminum I.D. washers for measure in the following: Existing - Maple 10", N.10 E., 7.98 feet. \* Existing - Maple 14", N.64 E., 8.00 feet. \* Existing - Maple 18", S.04 E., 25.09 feet. \* Existing - Maple 20", S.42 W., 49.54 feet. \* Survey marker sign on 6 foot steel post, S.27 E., 1.5 feet. \* All bearings are magnetic.

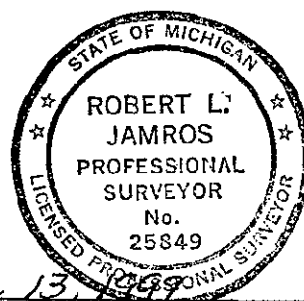

Signed by Robert L. Jamros Date Dec 13, 1999  
Surveyor's Michigan License No. 25849