

DEC 27 1999

SECTION

LAND CORNER RECORDATION CERTIFICATE
Filing Requirement of Act 74, Mich. P.A. 1970

Approved by Alger County
Land Survey Remonumentation
Peer Group Under Act 345 of
P.A. of 1990 On 12-8 1999

Donald W. Carlson
Chairman

05-154

For corners in


Alger (County)	Located In:	Corner Code #
1. Public Land Survey	T 48N R 15W	MC A10 A11 ✓
	T 48N R 16W	MC M10 M11
	T _____ R _____	_____
	T _____ R _____	#1
	T _____ R _____	_____
2. Property Controlling in Section	S _____ T _____ R _____	_____
	S _____ T _____ R _____	_____
3. Miscellaneous Property in Section	S _____ T _____ R _____	_____
	S _____ T _____ R _____	_____

FILED
TIME 1:30 p.m.

DEC 15 1999

DONALD W. KINNUNEN
REGISTER OF DEEDS
ALGER COUNTY, MI
Register of Deeds Stamp & File Number

4. Lot No. _____, Recorded Plat _____
5. Private Claims _____

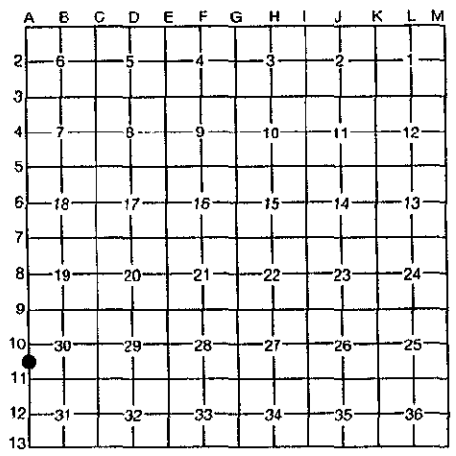

I, Robert L. Jamros, in a field survey on September 24, 1999, 19_____, do hereby state that under requirements of P.A. 74, Michigan P.A. of 1970, the corner points mentioned in lines 1 and 2 above were in conformance with regulations and rules therefore as required in the current manual of survey instructions of the United States Department of the Interior, Bureau of Land Management or by a decree of a Court of Law and/or that the corner points mentioned in lines 3, 4 and 5 above were in conformance with the rules of the Michigan Board of Land Surveyors or by a Decree of a Court of Law; established, re-established, monumented, _____ recovered, found as expressed below:

NOTE: Not more than 2 corners, all in the same town and range, may be recorded on this certificate.

A. Description of original monument and accessories and/or subsequent restoration:

MC1: PLS * William A. Burt, DS, 1841. * 7.18 chains, over lake, C E&W and set post. * W.Pine 24", N.40 W., 31 links. * No other subsequent restoration of record.

B. Description of corner evidence found and/or method applied in restoring or reestablishing corner:

MC1: Located corner search area by calculated position and standard field survey. Found 1"x4" decayed wooden hub at corner position, author unknown. Also found a petrified W.Pine stub at GLO position of N.40 W., 31 links. Open portion of blaze reveals portions of scribing, "M" and "T48", visible. Established corner position from GLO BT and decayed wooden hub, set monument. Corner position as established is accepted as a careful and faithful perpetuation of the position of the original corner.

C. Description of monument for corner and accessories established to perpetuate locating the position of the corner:

MC1: Set 2 1/2"x30" Berntsen aluminum monument No. A1NB30 with 3 1/4" aluminum cap stamped to identify corner position. * Established the following reference trees with BT signs, lower blazes, scribed and painted. * Set PK nails with aluminum I.D. washers for measure in the following: W.Pine 20", N.90 E., 23.60 feet, "BT". * Maple 10", N.26 W., 30.68 feet, "BT". * W.Pine 20", N.23 W., 4.90 feet, "BT". * Survey marker sign on 6 foot steel post, N.50 E., 1.5 feet. * All bearings are magnetic.



Signed by Robert L. Jamros
Surveyor's Michigan License No. 25849

Date Dec 15 1999