



19

#12

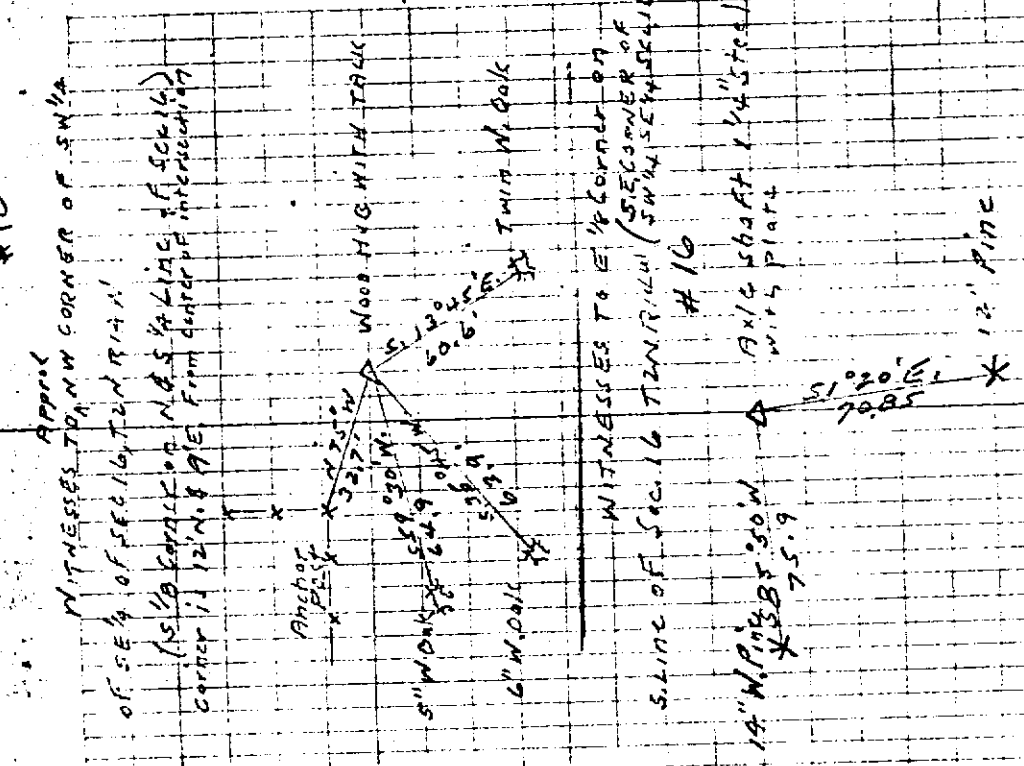

FROM ALLEGAN DAM # 26


F-5

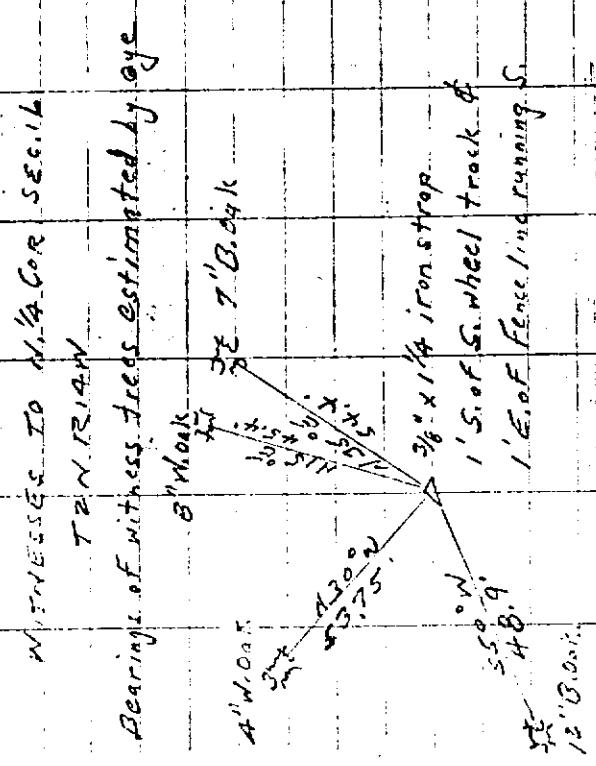

WITNESSES TO SW 1/4 COR SEC. 16 T14N R14W (SW COR GRAVEL PIT)


CORNER EST. MAY 1939 BY H.M. NATHAN & S.

F-7

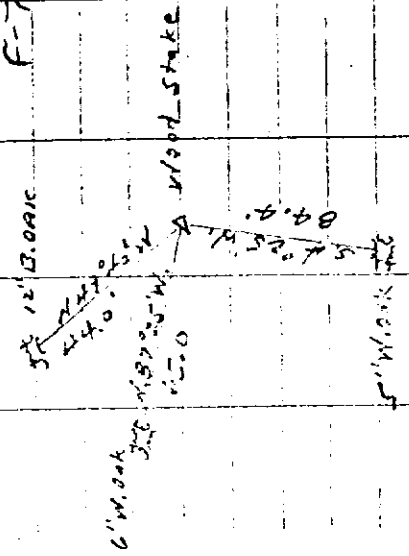


19

#12

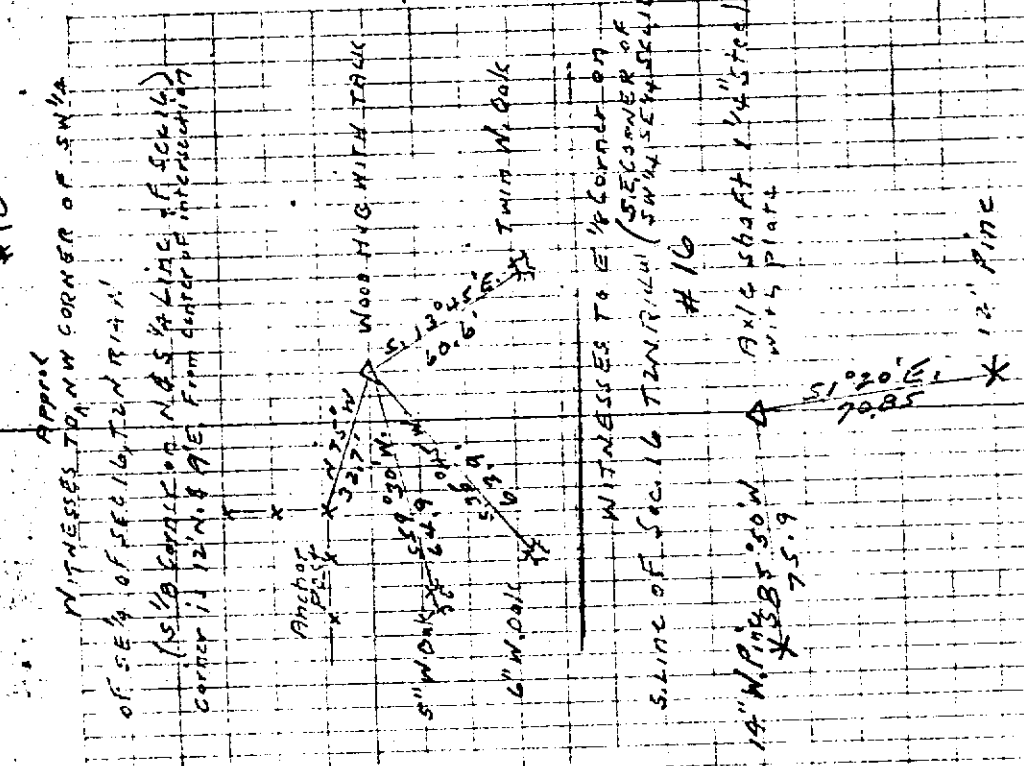

FROM ALLEGAN DAM # 26

F-5

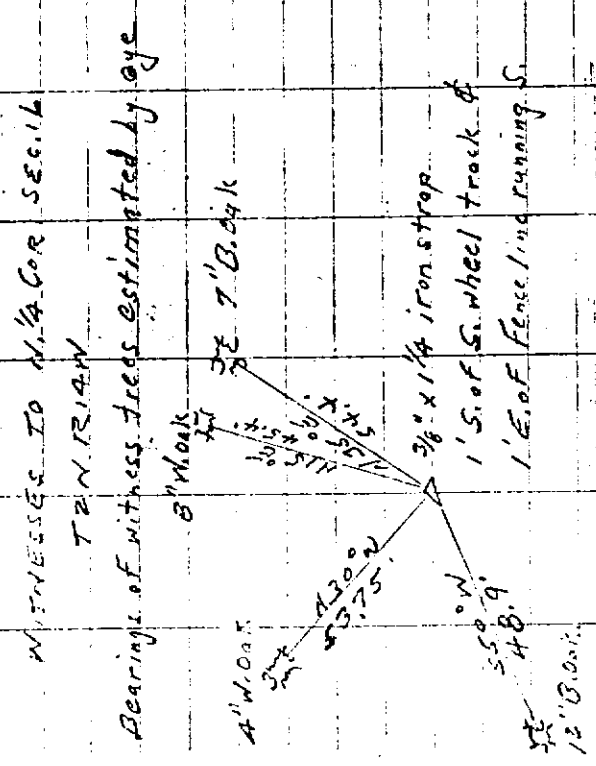

WITNESSES TO SW 1/4 COR SEC. 16 T14N R14W (SW COR GRAVEL PIT)

CORNER EST. MAY 1939 BY H.M. NATHAN & S.

F-7

