

MAR 07 2000

FILED

SECTION

ALLEGAN COUNTY REMONUMENTATION
LAND CORNER RECORDATION CERTIFICATE
Filing Requirement of Act 74, Mich. P.A. 1970

00 FEB -1 AM 8:40

For corners in
Allegan
(County)

Located In:

Corner Code #

Joyce A. Green
REGISTER OF DEEDS
ALLEGAN COUNTY, MI

1. Public Land Survey T2N R16W LM-8, Sequence
T R No. 4
T R
T R
T R
2. Property Controlling S T R
in Section S T R
3. Miscellaneous S T R
Property in Sec. S T R

Section 24
Ganges Twp.

Register of Deeds Stamp & File Number

4. Lot No. , Recorded Plat
5. Private Claims

I, Steve Lampen, in a field survey on December 22, 1999, do hereby certify that under requirements of P.A. 74, Michigan P.A. of 1970, the corner points mentioned in lines 1 and 2 above were in conformance with regulations and rules therefore as required in the current manual of survey instructions of the United States Department of the Interior, Bureau of Land Management or by a decree of a Court of Law and/or that the corner points mentioned in lines 3, 4 and 5 above were in conformance with the rules of the Michigan Board of Land Surveyors or by a Decree of a Court of Law; established, re-established, monumented, re-monumented, recovered, found as expressed below:

NOTE: Not more than 4 corners, all in the same town and range, may be recorded on this certificate.

A. Description of original monument and accessories and/or subsequent restoration:

M-8
GLO - 1831 - L. Lyon
Set post
Tamarack 6 S 15 W 53
Tamarack 6 N 27 W 25

No other records recovered

B. Description of corner evidence found and/or method applied in restoring or reestablishing corner:

M-8 No monumentation found at corner. No occupation towards the West or East at corner. Re-established corner mid-way and on line between M-7 and M-9. Corner falls in a large North and South drain. Set an Allegan County Remonumentation iron and yellow cap at a witness corner 50.0' West of M-8 on the East and West 1/4 line of Section 24.

See sketch on back.

Re-established location of M-8 and is accepted as a careful and faithful re-establishment of the position of the original corner.

Approved by the Allegan County Remonumentation Peer Group on December 28, 1999.

Traversed 5279' off road.

APPROVED REMONUMENTATION CORNER

P.A. 345 OF 1990

ALLEGAN COUNTY

DATE APPROVED DEC. 22, 1999


COUNTY REP. [Signature]

C. Description of monument for corner and accessories established to perpetuate locating the position of the corner:

LM-8, Sequence No. 4 - Allegan County Remonumentation iron and cap 50.0' West of M-8 on the East and West 1/4 line of Section 24

Azimuth = Michigan State Plane grid direction

1/2" diameter steel bar with cap #37279	209° 35'	28.84'
1/2" diameter steel bar with cap #37279	333° 18'	31.26'
1/2" diameter steel bar with cap #37279	83° 49'	116.58'
1/2" diameter steel bar with cap #37279	109° 58'	113.60'
Witness corner, 50' E of A-8, T2N, R15W	95° 29'	100.52'
M-8, T2N, R16W	89° 53'	50.0'

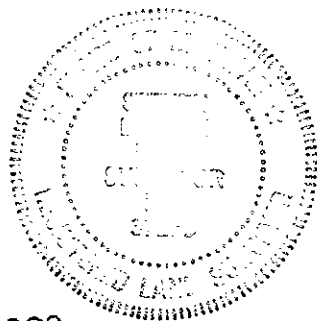

Signed by Steve Lampen

Date DECEMBER 31, 1999

Surveyor's Michigan License No. 37279

SURVEY &
RECONSTRUCTION

MAR 07 2000

SECTION

107000 / 1000000

