

LAND CORNER RECORDATION CERTIFICATE  
Filing Requirement of Act 74, Mich. P.A. 1970

For corners in  
Allegan

Located In:

Corner Code //

1. Public Land Survey

T 2N R 16W

K5

T 2N R 16W

MC S of M4

T R

T R

2. Property Controlling  
in Section

S 12

T 2N R 16W

16

S T R

3. Miscellaneous

S

T R

Property in Sec.

S

T R

Register of Deeds Stamp & File Number

4. Lot No. , Recorded Plat

5. Private Claims

16 April 12, 1993

MC April 14, 1993

K5 March 09, 1993

I, Gary C. Bilow

in a field survey on 19

do hereby certify that under requirements of P.A. 74, Michigan P.A. of 1970, the corner points mentioned in lines 1 and 2 above were in conformance with regulations and rules therefore as required in the current manual of survey instructions of the United States Department of the Interior, Bureau of Land Management or by a decree of a Court of Law and/or that the corner points mentioned in lines 3, 4 and 5 above were in conformance with the rules of the Michigan Board of Land Surveyors or by a Decree of a Court of Law; established, re-established, monumented, re-monumented, recovered, found as expressed below:

NOTE: Not more than 4 corners, all in the same town and range, may be recorded on this certificate.

A. Description of original monument and accessories and/or subsequent restoration:

K5: Post established by U.S. Deputy Surveyor C. Britain in 1831 - accessories: Beech 14 N19W 5 and Maple 11 S31E 21. Undated records obtained from Wightman-Moored state "2" iron - accessories: Maple 16 NE 29.5', Maple 12 SE 37.5', and Maple 16 SW 58". This same record from Wightman-Moored lists Road Commission witnesses: T.P. WSW 59.00', 24" Maple SSW 58.74', P.P. SSW 77.21', 24" Maple SSE 68.26', and 16" Maple ESE 45.26' with PK nail in all". Records dated 1977 obtained from Wightman-Moored state "5/8" iron - accessories: S30E 83.58' Power pole, N75E 79.2' Fence corner post, N30W 48.3' Stop sign post, and S65W 59.16' SE corner telephone outlet". Corner recorded under Act 132 PA 1970 in Liber 1099 Page 778 by R. Moored (PS 26463) as "5/8" iron with the same accessories".

MC S of M4: Post established by U.S. Deputy Surveyor C. Britain in 1831 - accessories: Maple 7 N40E 12 and Maple 7 N85W 24. No other records found.

16: Post not established by U.S. Government survey. No other record found.

B. Description of corner evidence found and/or method applied in restoring or reestablishing corner:

K5: Found 3/4" iron bar in Monument box and two (2) of Moored's witnesses. Accepted this corner as the best evidence of the original GLO post.

MC S of M4: Reestablished corner at single proportionate distance (GLO 483.12' to 483.82 prorated) between corners M5 and M4 (both recorded this date).

16: Established corner midway on line between corners L5 and M5 (both recorded this date).


C. Description of monument for corner and accessories established to perpetuate locating the position of the corner:

K5: Left 3/4" iron bar in monument box  
S65W 57.0', Southeast corner Tele. box  
S20E 83.58', PK nail in Power pole  
N45E 48.14', PK nail in sq. Fence post  
S75W 95.3', Stop sign post

MC S of M4: Set 1/2" x 24" rebar with  
plastic cap stamped "G.C. Bilow LLS  
26453" on West edge North-South ditch  
West 1', Steel post  
S34W 11.15', Nail & Tag in 6" Cherry  
S22E 20.68', Nail & Tag in 5" Cherry

16: Set 1/2" x 24" rebar with plastic  
cap stamped "G.C. Bilow LLS 26453" 0.4'  
below road surface  
Centerline East-West dirt road  
S56E 31.33', Nail & Tag in 7" Ash  
S22E 20.00', Nail & Tag in 6" Ash  
S38W 31.57', Nail & Tag in 8" Ash  
West 6', Centerline North-South 24" CMP

	A	B	C	D	E	F	G	H	I	J	K	L	M
2	6		5		4		3		2		1		
3													
4	7		8		9		10		11		12		
5													
6	18		17		16		15		14		13		
7													
8	19		20		21		22		23		24		
9													
10	30		29		28		27		26		25		
11													
12	31		32		33		34		35		36		
13													

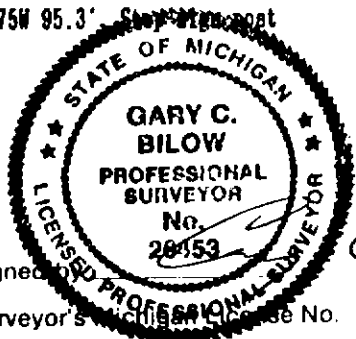

Signed  
Surveyor's License No.

Date

5/6/93