

SURVEY &
REMONUMENTATION

APR 29 1996

COMMISSION

Allegan County Remonumentation
LAND CORNER RECORDATION CERTIFICATE
Filing Requirement of Act 74, Mich. P.A. 1970

For corners in

Allegan
(County)

Located in:

Corner Code xx

1. Public Land Survey

T R

LM-1 Martin Twp.

T R

LM-13 Wayland Twp.

T R

Wayland Twp.

T R

Martin Twp.

2. Property Controlling

S 36 T 3N R 11W

Wayland Twp.

in Section

S 1 T 2N R 11W

Martin Twp.

3. Miscellaneous

S T R

Property in Sec.

S T R

4. Lot No. , Recorded Plat

5. Private Claims

FILED
1995 DEC 29 PM 4:05
REGISTER OF DEEDS
ALLEGAN COUNTY, MICHIGAN
James A. Bueche

Register of Deeds Stamp & File Number

I, John C. Bueche, in a field survey on March 15, 19 95,
do hereby certify that under requirements of P.A. 74, Michigan P.A. of 1970, the corner points mentioned
in lines 1 and 2 above were in conformance with regulations and rules therefore as required in the
current manual of survey instructions of the United States Department of the Interior, Bureau of Land
Management or by a decree of a Court of Law and/or that the corner points mentioned in lines 3, 4 and 5
above were in conformance with the rules of the Michigan Board of Land Surveyors or by a Decree of a
Court of Law; established, re-established, monumented, re-monumented, recovered, found as
expressed below:

NOTE: Not more than 4 corners, all in the same town and range, may be recorded
on this certificate.

A. Description of original monument and accessions and/or subsequent restoration:

APPROVED REMONUMENTATION CORNER

P.A. 345 OF 1990


ALLEGAN COUNTY

DATE APPROVED 8-14-95

COUNTY REP. *Robert L. Bueche*

B. Description of corner evidence found and/or method applied in restoring or reestablishing corner:


Set Allegan Co. Mon. on South of Sec. 36, 3-11 on the West shore of
Gun Lake. Extending the S 1/4 cor. Sec. 36, 3-11 and iron in Mon.
Box (124th Ave. & Patterson Ave.) East to Lake

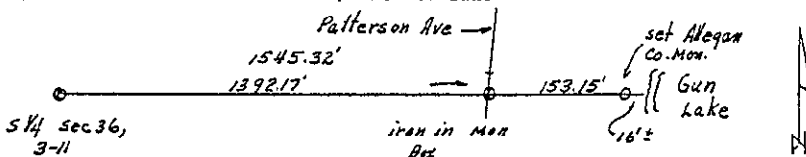

This position not established by original government surveyors. This monument is
accepted as the best available evidence of the position of the corner.

C. Description of monument for corner and accessions established to perpetuate locating the position of the corner:

Allegan Co. Mon. (3/4" x 24" Pin & Cap)
NE cor. conc. sea wall N 90 E 15.67'
SE cor. hse. fnd. S 40 W 16.65'
NE cor. hse. fnd. S 85 W 12.85'
Face 2" steel fence post N 40 W 2.8'±
Iron in Mon. Box West 153.15' (on Patterson Ave.)
Capped JCB iron North 14.27'

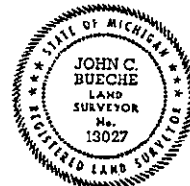

Signed by John C. Bueche
Surveyor's Michigan License No. 13027

Date Oct 2, 1995

FORM APPROVED BY MICHIGAN STATE BOARD OF LAND SURVEYORS, JAN. 28, 1977
REVISED MAY 14, 1979
REVISED JAN., 1983

10005 PAGE 326