

**LAND CORNER RECORDATION CERTIFICATE**  
**Filing Requirement of Act 74, Mich. P.A. 1970**

For corners in  
**ALLEGAN**

(County)

Located In:

Corner Code = *tt*

1. Public Land Survey	T	3N	R	15W	I-11
	T	3N	R	15W	J-11
	T		R		
	T		R		
2. Property Controlling in Section	S		T	R	
	S		T	R	
3. Miscellaneous	S		T	R	
Property in Sec.	S		T	R	

Register of Deeds Stamp & File Number

4. Lot No. \_\_\_\_\_, Recorded Plat \_\_\_\_\_  
 5. Private Claims \_\_\_\_\_

I, GARY C. BILOW, in a field survey on APRIL 15, 19 91, do hereby certify that under requirements of P.A. 74, Michigan P.A. of 1970, the corner points mentioned in lines 1 and 2 above were in conformance with regulations and rules therefore as required in the current manual of survey instructions of the United States Department of the Interior, Bureau of Land Management or by a decree of a Court of Law and/or that the corner points mentioned in lines 3, 4 and 5 above were in conformance with the rules of the Michigan Board of Land Surveyors or by a Decree of a Court of Law; established, re-established, monumented, re-monumented, recovered, found as expressed below:

**NOTE: Not more than 4 corners, all in the same town and range, may be recorded on this certificate.**

	A	B	C	D	E	F	G	H	I	J	K	L	M
2		6		5		4		3		2		1	
3													
4		7		8		9		10		11		12	
5													
6		18		17		16		15		14		13	
7													
8		19		20		21		22		23		24	
9													
10		30		29		28		27		26		25	
11													
12		31		32		33		34		35		36	
13													

**A. Description of original monument and accessories and/or subsequent restoration:**

(I-11) CORNER ESTABLISHED BY U.S. GOVERNMENT DEPUTY SURVEYOR C. BRITAIN, 1832. ACCESSORIES: PINE 18 N31E 32, PINE 12 S89W 23. CORNER SHOWN IN ALLEGAN COUNTY SURVEYORS RECORD BY E.P. WATERMAN IN MAY 1887 AS "2 STONES, 1 WIT. TREE LEFT". CORNER SHOWN IN BOOK 4 PAGE 160 OF FIELD SURVEY NOTES ca. 1937 OF UNKNOWN SURVEYOR AS STONE 6" BELOW SURFACE WITH ACCESSORIES: 14" W. OAK N74E 77.7', 14" W. OAK S36°30'W 34.0', COR. F. POST N1°30'W 21.8'. CORNER RECORDED UNDER ACT 74, P.A. 1970 BY D.A. RATEKIN 4-18-1972 AS "FOUND STONE 2' DEEP WITH WOOD STAKE DRIVEN ON WEST SIDE". RATEKIN PERPETUATED WITH 5/8" IRON AND ACCESSORIES AS NOTED ON LCRC LIBER 1 PAGE 270. CORNER RECORDED BY RUSSELL ROON 7-14-72 AS FOUND 5/8" IRON WITH RATEKIN'S ACCESSORIES (LCRC LIBER 1, PAGE 349). (J-11) ORIGINAL POST ESTABLISHED BY U.S. GOVERNMENT DEPUTY SURVEY C. BRITAIN, 1832. ACCESSORIES: PINE 18 S31/2W 18, PINE 9 N91/2W 37. CORNER RECORDED UNDER ACT 74, P.A. 1970 4-18-1972 BY D.A. RATEKIN AS "FOUND STONE, SET 1 1/4" ANGLE IRON". ACCESSORIES: BLAZED 16" OAK S10E 79.65', BLAZED 20" OAK S35W 93.5', W. GATE POST N15W 31.4', E. GATE POST N15E 34.3', CL OF E&W ROAD 10' N, IN LINE WITH DRIVE TO N, 66' W OF E LINE TO N. (RECORDED ON LCRC LIBER 1, PAGE 271)

**B. Description of corner evidence found and/or method applied in restoring or reestablishing corner:**


(I-11) ORIGINAL POST AND ACCESSORIES NOT RECOVERED. FOUND TRIANGULAR SHAPED BLUE STONE APPROX. 12" LONG WITH 1/2" IRON BAR AND A SECOND 12" LONG STONE ADJACENT. 1937 TIE TO 14" (NOW 22") W. OAK CHECKS. CORNER FENCE POST TIE CHECKS TO OLD WIRE REMAINS. RATEKIN'S TIES TO 12" OAK NW AND USGS STATION CHECK. ACCEPTED STONES AND IRON AS A CAREFUL AND FAITHFUL PERPETUATION OF THE LOCATION OF THE ORIGINAL MONUMENT AND REPLACED SAME WITH 1/2"x36" REBAR ENCASED IN A 4" DIAMETER CONCRETE CYLINDER CAPPED WITH A CAST ALUMINUM MICHIGAN DEPARTMENT OF NATURAL RESOURCES TABLET.

(J-11) ORIGINAL POST AND ACCESSORIES NOT RECOVERED. FOUND 1 1/4" ANGLE IRON ABOVE LARGE STONE. RATEKIN'S ACCESSORIES TO 16" OAK AND TO CL OF E&W ROAD CHECK. ACCEPTED ANGLE IRON AND STONE AS THE BEST AVAILABLE EVIDENCE OF THE ORIGINAL CORNER LOCATION AND REPLACED ANGLE IRON WITH AN MDNR CONCRETE MONUMENT AS DESCRIBED ABOVE.

**C. Description of monument for corner and accessories established to perpetuate locating the position of the corner:**

(I-11) SET MDNR CONCRETE MONUMENT	(J-11) SET MDNR CONCRETE MONUMENT
N65E 33.59' SET NAIL AND MDNR TAG IN 24" OAK	N23W 46.10' SET NAIL AND MDNR TAG IN WEST FACE BLAZED 8" OAK
N30E 20.50' SET NAIL AND MDNR TAG IN WEST FACE OF 6"	S10E 80.09' SET NAIL AND MDNR TAG IN WEST FACE BLAZED 18" OAK
AND 10" TWIN CHERRY	WEST 66.00' FOUND 1" IRON PIPE WITH CAP #18665
N60W 22.83' SET NAIL AND MDNR TAG IN E FACE 12" OAK	NORTH 10' CENTERLINE OF GRAVEL SURFACE OF 126TH AVENUE
S35W 33.99' SET NAIL AND MDNR TAG IN NW FACE 27" OAK	
EAST 12' CENTERLINE OF GRAVEL ROAD TO SOUTH	
(BLAZED ALL TREES EXCEPT 27" OAK WITH BASE BLAZES)	

Signed by Gary C. BiLOW Date \_\_\_\_\_  
 Surveyor's Michigan License No. 26453

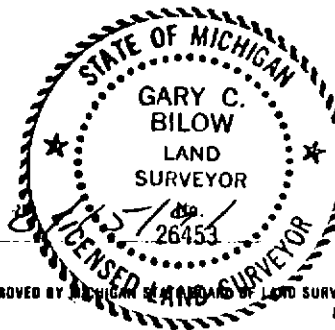

FORM APPROVED BY MICHIGAN BOARD OF LAND SURVEYORS, JAN. 28, 1971  
 REVISED MAY 14, 1975  
 REVISED JAN., 1983