

SURVEY
REMONUMENTATION

APR 29 1999

Allegan County Remonumentation

SECTION

LAND CORNER RECORDATION CERTIFICATE
Filing Requirement of Act 74, Mich. P.A. 1970

For corners in

Allegan

(County)

Located In:

Corner Code #

4N 11W M-10 (E 1/4, Sec.25)

1. Public Land Survey

T___ R___ Leighton Twp.

T___ R___

T___ R___

T___ R___

2. Property Controlling
in Section

S___ T___ R___

S___ T___ R___

3. Miscellaneous
Property in Sec.

S___ T___ R___

S___ T___ R___

4. Lot No. _____, Recorded Plat _____

5. Private Claims _____

Steven Koerber

May 9, 98

I, _____, in a field survey on _____, 19____ do hereby state that under requirements of P.A. 74, Michigan P.A. of 1970, the corner points mentioned in lines 1 and 2 above were in conformance with regulations and rules therefore as required in the current manual of survey instructions of the United States Department of the Interior, Bureau of Land Management or by a decree of a Court of Law and /or that the corner points mentioned in lines 3, 4 and 5 above were in conformance with the rules of the Michigan Board of Land Surveyors or by a Decree of a Court of Law; established, re-established, monumented, recovered, found as expressed below:

NOTE: Not more than 2 corners, all in the same town and range, may be recorded on this certificate.

A. Description of original monument and accessories and/or subsequent restoration:

M-10 GLO Set Post, Lucius Lyons DS, 1826

B. Oak 8 S3 1/2W 37

W. Oak 20 N76E 23

I. L.C.R.C. Liber 4, Pg. 188 Basil Address (Feb. 16, 1993)

1/2" iron

1/2" iron North 9.60 feet (West 1/4 corner Sec. 30-4-10)

In centerline Road

NE corner Sec 25-4-11 N00°02'00"W 2554.91'

SE corner Sec 25-4-11 S00°00'00"W 2645.05'

B. Description of corner evidence found and/or method applied in restoring or reestablishing corner:

M-10 Found 1/2" Iron rerod in Mon. Box

1/2" iron in Mon. box North 9.60 feet (West 1/4 corner Sec. 30-4-10)

In centerline Road

NE corner Sec 25-4-11 M= 2554.87'

SE corner Sec 25-4-11 M= 2644.99'

APPROVED REMONUMENTATION CORNER

P.A. 345 OF 1990

ALLEGAN COUNTY

DATE APPROVED MAY 12, 1998

COUNTY REP. *[Signature]*

And is accepted as a careful and faithful perpetuation of the position of the original corner.

Peer Group approval May 12, 1998

C. Description of monument for corner and accessories established to perpetuate locating the position of the corner:

M-10 Replaced 1/2" Iron rerod with Allegan Co. Mon. (3/4" x 24" Iron Rod with cap)


Set nail & Allegan Co. Remon. Tag in N. side 8" Ash N90°W 49.01'

Set 3/4" x 24" Allegan Co. Remon. rod N60°E 66.93'

Found Exxel capped rerod S55°E 40.28'

1/2" iron in Mon. box North 9.60 feet (West 1/4 corner Sec. 30-4-10)

In centerline of Patterson Road

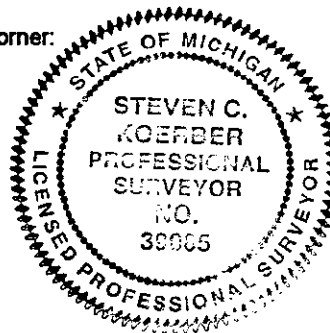

Signed by *[Signature]*

Date 6-11-1998

Surveyor's Michigan License No. 39085