

RE

MAR 17 2000

Allegan County Remonumentation
LAND CORNER RECORDATION CERTIFICATE
 Filing Requirement of Act 74, Mich. P.A. 1970

For corners in
 Allegan

SECTION

Located In:
 Salem Twp.

Corner Code #

1. Public Land Survey

T 4N R 13W

J-3

2. Property Controlling
in Section

S

T

R

3. Miscellaneous
Property in Sec.

S

T

R

4. Lot No. _____, Recorded Plat _____

5. Private Claims _____

I, Robert J Jonker, in a field survey on 12-13, 1999 do hereby state that under requirements of P.A. 74, Michigan P.A. of 1970, the corner points mentioned in lines 1 and 2 above were in conformance with regulations and rules therefore as required in the current manual of survey instructions of the United States Department of the Interior, Bureau of Land Management or by a decree of a Court of Law and /or that the corner points mentioned in lines 3, 4 and 5 above were in conformance with the rules of the Michigan Board of Land Surveyors or by a Decree of a Court of Law; established, re-established, monumented, recovered, found as expressed below:

NOTE: Not more than 2 corners, all in the same town and range, may be recorded on this certificate.

A. Description of original monument and accessories and/or subsequent restoration:

GLO Set qr. Sec. post
 Beech 14 S46 E 26
 Sugar 18 N78 W 10

over

B. Description of corner evidence found and/or method applied in restoring or reestablishing corner:

Found rerod in mon box by the witnesses listed in "A" (over)
 Replaced with 3/4" X 36" std. Allegan Co. Monument

And is accepted as a careful and faithful perpetuation of the position of the original corner.

APPROVED REMONUMENTATION CORNER
 P.A. 345 OF 1990
 ALLEGAN COUNTY
 DATE APPROVED DEC. 14, 1999
 COUNTY REP. Robert J. Jonker

Peer group approved 12-14-99

C. Description of monument for corner and accessories established to perpetuate locating the position of the corner:

Allegan County Monument
 PK Nail SE side p. pole S45°W 45.0'
 nail & remon tag SW side 12" Poplar N67°W 86.32'
 nail & remon tag W side 12" Elm N0°E 47.33'
 nail & remon tag NW side 10" poplar N72°E 85.56'
 Rerod North 50.04'
 On C/L of E-W road, C/L of road to South is 2' East

Signed by

Robert J. Jonker

Date

12-14-99Surveyor's Michigan License No. 21572

REGISTER OF DEEDS
 ALLEGAN COUNTY, MICH.
Robert J. Jonker


00 FEB -1 11 8 49

FILED

RECORDED / INDEXED

Register of Deeds Stamp & File Number

	A	B	C	D	E	F	G	H	I	J	K	L	M
1													
2	6		5		4		3		2		1		
3													
4	7		8		9		10		11		12		
5													
6	18		17		16		15		14		13		
7													
8	19		20		21		22		23		24		
9													
10	30		29		28		27		26		25		
11													
12	31		32		33		34		35		36		
13													

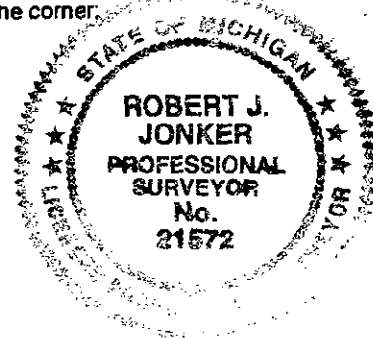

MAR 07 2000

J-3 Part "A" cont.

SECTION

Jonker 1999

LCRC #3-85 Ratekin 1976

Part B Found iron over stone

4" steel pipe SE 45.05'

Nail SE side p. pole SW 36.78'

Nail NE side T. pole NW 36.23'

SW Corner steel post, North 29.54'

Part "C"

$\frac{1}{2}$ " irons rod North 50' and 100'

Out
Out
Out
Out

M=50.04'

LCRC #3-67, CP Co. 1976

Part B, Found 1" pipe 18" below surface;
brought to surface with rebar & cap.

Part C

p. pole S45°W 45.09'

Rd sign N15°E 25.81'

Tel. Riser box N35°W 46.57'

M=45.0' to PK Check OK
Out
Check +-

Card file

1/2 to W. 2632.34

1/2 to E. 2632.34

Jonker Land Surveys 1983

Record survey Liber 1061, Page 201+-

Same as part "C" of 3-67