

LAND CORNER RECORDATION CERTIFICATE
Filing Requirement of Act 74, Mich. P.A. 1970

For corners in

<u>Alpena</u> (County)	Located In:	Corner Code #
1. Public Land Survey	T <u>29N</u> R <u>6E</u>	<u>J-5</u>
	T _____ R _____	
2. Property Controlling in Section	S <u>11</u> T <u>29N</u> R <u>6E</u>	<u>15</u>
	S _____ T _____ R _____	
3. Miscellaneous Property in Sec.	S _____ T _____ R _____	
	S _____ T _____ R _____	

Register of Deeds Stamp & File Num

4. Lot No. _____, Recorded Plat _____

5. Private Claims _____

I, Carl T. Kiiskila, in a field survey on July 01, 19 98 do hereby state that under requirements of P.A. 74, Michigan P.A. of 1970, the corner points mentioned in lines 1 and 2 above were in conformance with regulations and rules therefore as required in the current manual of survey instructions of the United States Department of the Interior, Bureau of Land Management or by a decree of a Court of Law and /or that the corner points mentioned in lines 3, 4 and 5 above were in conformance with the rules of the Michigan Board of Land Surveyors or by a Decree of a Court of Law; established, re-established, monumented, recovered, found as expressed below:

	A	B	C	D	E	F	G	H	I	J	K	L	M
1													
2		6		5		4		3		2		1	
3													
4		7		8		9		10		11		12	
5													
6		18		17		16		15		14		13	
7													
8		19		20		21		22		23		24	
9													
10		30		29		28		27		26		25	
11													
12		31		32		33		34		35		36	
13													

NOTE: Not more than 2 corners, all in the same town and range, may be recorded on this certificate.

A. Description of original monument and accessories and/or subsequent restoration:

J-5 GLO set section post – Lewis Clason D.S. 1839.
Wit: Yellow Pine 18" S 25° E 55 links
Beech 11" N 24° W 2 links

15 - This position was not established during the original government survey.

B. Description of corner evidence found and/or method applied in restoring or reestablishing corner:

J-5 Reestablished the South Quarter Corner of Section 11 midway and on line between found corners 1/2 mile to the east and west.

15 - Established the Southwest Corner of the Southeast Quarter of the Southwest Quarter of Section 11 per standard BLM instructions for subdivision of a section.

C. Description of monument for corner and accessories established to perpetuate locating the position of the corner:


J-5 Set 5/8" x 32" rerod with cap in northerly edge of road.
Wit: Set nail in 14" Oak N 76° W 55.91'
Set nail in 16" Oak S 45° W 54.98'
Set nail in 6" Maple clump N 64° E 32.23'
Set nail in 22" Oak S 40° E 69.66'
Centerline east-west road South 12' ±
Old north-south smooth wire West 8' ±
Carsonite marker post North 20' ±

15 - Set 5/8" x 32" rerod with cap and set carsonite marker post.
Wit: Set nail in 6" White Birch clump N 70° E 20.40'
Set nail in 16" Oak S 25° E 13.25'
Set nail in 6" Maple S 81° W 43.45'
Set nail in 8" Maple N 8° W 37.52'
Carsonite post set East 20' ±

Signed by

Carl T Kiiskila

Surveyor's Michigan License No. 33981

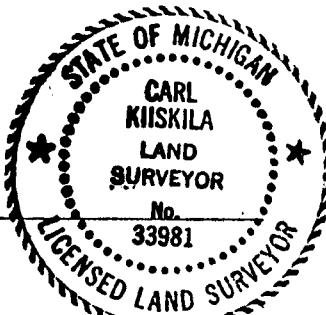

Date

6-14-99