

LAND CORNER RECORDATION CERTIFICATE
Filing Requirement of Act 74, Mich. P.A. 1970

For corners in

<u>Alpena</u> (County)	Located In:	Corner Code #
1. Public Land Survey	T <u>29N</u> R <u>6E</u>	<u>K-1</u>
	T <u>29N</u> R <u>6E</u>	<u>J-1</u>
2. Property Controlling in Section	S <u> </u> T <u> </u> R <u> </u>	<u> </u>
	S <u> </u> T <u> </u> R <u> </u>	<u> </u>
3. Miscellaneous Property in Sec.	S <u> </u> T <u> </u> R <u> </u>	<u> </u>
	S <u> </u> T <u> </u> R <u> </u>	<u> </u>

Register of Deeds Stamp & File Num

4. Lot No. , Recorded Plat

5. Private Claims

I, Carl T. Kiiskila, in a field survey on June 28, 19 98 do hereby state that under requirements of P.A. 74, Michigan P.A. of 1970, the corner points mentioned in lines 1 and 2 above were in conformance with regulations and rules therefore as required in the current manual of survey instructions of the United States Department of the Interior, Bureau of Land Management or by a decree of a Court of Law and /or that the corner points mentioned in lines 3, 4 and 5 above were in conformance with the rules of the Michigan Board of Land Surveyors or by a Decree of a Court of Law; established, re-established, monumented, recovered, found as expressed below:

1	A	B	C	D	E	F	G	H	I	J	K	L	M
2		6		5		4		3		2		1	
3													
4	7		8		9		10		11		12		
5													
6	18		17		16		15		14		13		
7													
8	19		20		21		22		23		24		
9													
10	30		29		28		27		26		25		
11													
12	31		32		33		34		35		36		
13													

NOTE: Not more than 2 corners, all in the same town and range, may be recorded on this certificate.

A. Description of original monument and accessories and/or subsequent restoration:

- | | | | |
|------|---|-----|--|
| K-1 | GLO set post – Lewis Clawson D.S. 1839. | J-1 | This corner was not established during the original government survey. |
| Wit: | Cedar 10" S 27° E 24 links | | |
| | Soft Maple 9" S 26° W 26 links | | |


B. Description of corner evidence found and/or method applied in restoring or reestablishing corner:

- | | | | |
|-----|--|-----|---|
| K-1 | Found and accepted a 6" spike located at the centerline of an east-west gravel road and at the centerline of a gravel road south fitting occupation. This position also fits a 1904 survey, done by Jos. McNeil, County Surveyor in Section 1. | J-1 | Found and accepted a 1/2" rerod as set by W. Lewis, PS #41922, set midway and on line between found corners one half mile to the east and west. |
|-----|--|-----|---|

C. Description of monument for corner and accessories established to perpetuate locating the position of the corner:

- | | | | |
|------|--|------|---|
| K-1 | Found 6" spike. Set 5/8" x 32" rerod with cap and set carsonite marker post. | J-1 | Found 1/2" rerod set by W. Lewis, PS #41922. Set carsonite marker post. |
| Wit: | Power pole S 46° W 44.56' | Wit: | Set nail in 6" Oak West 3.02' |
| | Fence corner post S 28° E 40.78' | | Set nail in 12" Maple S 16° W 38.24' |
| | Set nail in 4" Ash N 77° E 26.75' | | Set nail in 18" twin Oak S 53° E 57.17' |
| | Set nail in 4" Spruce N 64° W 52.87' | | Set nail in 10" Oak N 10° E 66.15' |
| | Carsonite post set North 33' | | Centerline of east-west pipeline South 16' ± |
| | | | Carsonite post set North 1' |

Signed by Carl T Kiiskila
Surveyor's Michigan License No. 33981

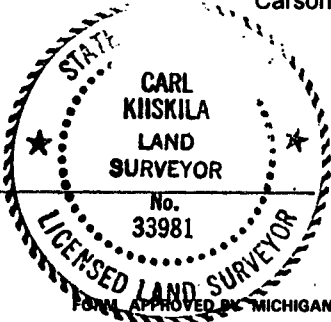

Date 6-14-99