

# 1999 Alpena County Remonumentation

## LAND CORNER RECORDATION CERTIFICATE Filing Requirement of Act 74, Mich. P.A. 1970

For corners in

Alpena

(County)

Located In:

Corner Code #

1. Public Land Survey

T 32N R 06E

F-7

T R

T R

T R

2. Property Controlling  
in Section

S

T R

S

T R

3. Miscellaneous  
Property in Sec.

S

T R

S

T R

4. Lot No. \_\_\_\_\_, Recorded Plat \_\_\_\_\_

5. Private Claims \_\_\_\_\_

I, Wayne T. Lewis, in a field survey on 6-01, 19 99 do hereby state that under requirements of P.A. 74, Michigan P.A. of 1970, the corner points mentioned in lines 1 and 2 above were in conformance with regulations and rules therefore as required in the current manual of survey instructions of the United States Department of the Interior, Bureau of Land Management or by a decree of a Court of Law and /or that the corner points mentioned in lines 3, 4 and 5 above were in conformance with the rules of the Michigan Board of Land Surveyors or by a Decree of a Court of Law; established, re-established, monumented, recovered, found as expressed below:

NOTE: Not more than 2 corners, all in the same town and range, may be recorded on this certificate.

### A. Description of original monument and accessories and/or subsequent restoration:

1856: Josiah Knauer set post and witnessed

1901: Wm. H. Leroy found old stake and set 3" square stake and witnessed

1976: R. S. Scott (D. B. Guthrie, P.S.) used corner for section break down, no monumentation or witnesses given

1992: E. T. Lewis, P.S., set 1/2" rod, and witnessed

### B. Description of corner evidence found and/or method applied in restoring or reestablishing corner:

Set 1/2" rerod from 1992 E.T.L. witnesses, corner falls in Greenwood Rd. C/L

This corner position is accepted as a careful and faithful perpetuation of the position of the original corner.

### C. Description of monument for corner and accessories established to perpetuate locating the position of the corner:

1999: Placed 3" Alpena County Cap, stamped to identify the corner, on set 1/2" rerod, 6" below road surface

Witnesses:

North 32.96' Exist. 1/2" Rerod w/cap #27452

N 5° E 33.80' 8" Cedar (Set Tag #41922 over Exist. Roofing Nail)

N 60° E 45.89' Power Pole

S 45° W 36.88' Yellow Birch

N 75° W 65.65' 8" Cedar (Set Tag #41922 over Exist. Roofing Nail)

Signed by

*Wayne T. Lewis*

Date November 24, 1999

Surveyor's Michigan License No.

41922

REGISTER OF DEEDS


JAN 21 2000

SECTION

Register of Deeds Stamp & File Number

	A	B	C	D	E	F	G	H	I	J	K	L	M
1													
2	6		5		4		3		2		1		
3													
4	7		8		9		10		11		12		
5													
6	18		17		16		15		14		13		
7													
8	19		20		21		22		23		24		
9													
10	30		29		28		27		26		25		
11													
12	31		32		33		34		35		36		
13													

P.A. 345 ALPENA COUNTY  
PEER APPROVED 9/14/99

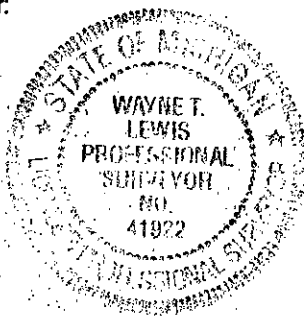

L-2 P-257

11/30/1999 03:30P

Page: 1 of 1

Kathy J. Matash, Register Alpena Co., MI LDC 9.00

FORM APPROVED BY MICHIGAN STATE BOARD OF PROFESSIONAL SURVEYORS, JAN. 20, 1971  
REVISED MAY 14, 1975  
REVISED JAN., 1983  
REVISED OCT., 1995