

JAN 27 2000

LAND CORNER RECORDATION CERTIFICATE
Filing Requirement of Act 74, Mich. P.A. 1970

Liber 00003 Page 0090

SECTION

For corners in

ANTRIM (County)	Located In:	Corner Code #
1. Public Land Survey	T 29N R 8W	K-7
	T R	
	T R	
	T R	
2. Property Controlling in Section	S T R	
	S T R	
3. Miscellaneous Property in Sec.	S T R	
	S T R	

ANTRIM COUNTY MI.
Register of Deeds
Recorded

12-20-1999 10:10:49


Wanda R. Conway
REGISTER OF DEEDS

Register of Deeds Stamp & File Number

4. Lot No. _____, Recorded Plat _____
5. Private Claims _____

I, NEIL L. WAY, in a field survey on 12-15, 1999 do hereby state that under requirements of P.A. 74, Michigan P.A. of 1970, the corner points mentioned in lines 1 and 2 above were in conformance with regulations and rules therefore as required in the current manual of survey instructions of the United States Department of the Interior, Bureau of Land Management or by a decree of a Court of Law and /or that the corner points mentioned in lines 3, 4 and 5 above were in conformance with the rules of the Michigan Board of Land Surveyors or by a Decree of a Court of Law, established, re-established, monumented, recovered, found as expressed below:

NOTE: Not more than 2 corners, all in the same town and range, may be recorded on this certificate.

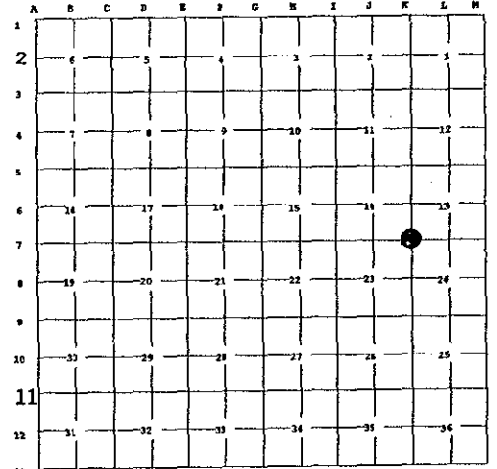

A. Description of original monument and accessories and/or subsequent restoration:

K-7 GLO SET POST 1850, BEECH 14 S48E 45, SUGAR 10 N72W 43
CHURCH MAY 1888 FOUND GOVT STK. WIT'S GONE SET CEDAR STK SUB SEC 14.
CHURCH APRIL 1909 FOUND HIS STK AND BURIED A BOULDER POINT, SUB SEC 23.
LENNOX MAY 7, 1985 FOUND AND WIT A CORNER USED BUT NOT RECORDED BY
OSTLING IN A SURVEY.
LENNOX AND SMITH JUNE 26 1996 FOUND PREVIOUS IRON AS DESCRIBED ABOVE
AND FILED LCR LIB 002 PG 302.

3. Description of corner evidence found and/or method applied in restoring or reestablishing corner:

K-7 FOUND 1/2" IRON ROD AND WIT'S IN AGREEMENT WITH ABOVE.


Ratified by Peer Group
in accordance with
P.O. 345
Antrim Co. Chairman

Arthur L. Lennox
Arthur L. Lennox
Nov. 10, 1999

2. Description of monument for corner and accessories established to perpetuate locating the position of the corner:

K-7 REMOVED 1/2" IRON ROD AND SET COUNTY MONUMENT AND MONUMENT BOX.

N02E 56.12' P.POLE
S30E 64.36' RED PINE 9"
S57W 47.03' IRON PIPE
N67E 123.82' P.POLE

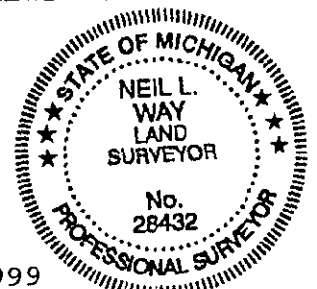

Signed by *Neil L. Way*

Date DEC 15, 1999

Surveyor's Michigan License No. 28432