

JAN 27 2000

SECTION

LAND CORNER RECORDATION CERTIFICATE

Filing Requirement of Act 74, Mich. P.A. 1970 ANTRIM COUNTY MI.

For corners in

HELENA TWP.

Register of Deeds
RecordedAntrim

Located In:

Corner Code #

(County)

12-14-1999 13:39:11

Manda R. Conway
REGISTER OF DEEDS

1. Public Land Survey

24

T29N R8W

L-9

2. Property Controlling
in Section

S

T R

3. Miscellaneous
Property in Sec.

S

T R

4. Lot No. _____, Recorded Plat _____

5. Private Claims _____

Register of Deeds Stamp & File Number

I, Terry B. Smith, in a field survey on Nov. 18, 1999 do hereby state that under requirements of P.A. 74, Michigan P.A. of 1970, the corner points mentioned in lines 1 and 2 above were in conformance with regulations and rules therefore as required in the current manual of survey instructions of the United States Department of the Interior, Bureau of Land Management or by a decree of a Court of Law and/or that the corner points mentioned in lines 3, 4 and 5 above were in conformance with the rules of the Michigan Board of Land Surveyors or by a Decree of a Court of Law; established, re-established, monumented, recovered, found as expressed below:

NOTE: Not more than 2 corners, all in the same town and range, may be recorded on this certificate.

A. Description of original monument and accessories and/or subsequent restoration:

GLD circa Oct. 1850 no evidence found
F. Church 1914


B. Description of corner evidence found and/or method applied in restoring or reestablishing corner:

found 1/2" steel bar LS#33969
excavation revealed 1/2" steel bar 28" deep
witnesses check with prior usage


C. Description of monument for corner and accessories established to perpetuate locating the position of the corner:

Set Antrim co. monument
8" Basswood N20W 39.90
15" Basswood N45W 64.90
10" Scotch Pine S45W 55.20
UP N15E 40.40

Ratified by Peer Group
In accordance with
P.O. 345
Antrim Co. Chairman

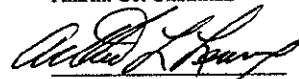

Arthur L. Lennox
Nov. 10, 1999

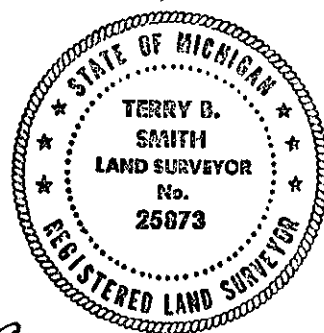

Signed by

Date 12-14-1999Surveyor's Michigan License No. 25873