

JAN 7 2000

Liber 00003 Page 0088

LAND CORNER RECORDATION CERTIFICATE
Filing Requirement of Act 74, Mich. P.A. 1970

SECTION

For corners in

ANTRIM

(County)

Located In:

Corner Code #

1. Public Land Survey

T R

T R

T R

T R

2. Property Controlling
in Section

S T R

S T R

3. Miscellaneous

S21 T29N R8W

Property in Sec.

S T R

#001

ANTRIM COUNTY MI.
Register of Deeds
Recorded

12-20-1999 10:10:08

Manda R. Conway
REGISTER OF DEEDS


Register of Deeds Stamp & File Number

4. Lot No. , Recorded Plat

5. Private Claims

I, NEIL L. WAY, in a field survey on DEC 15, 1999 do hereby state that under requirements of P.A. 74, Michigan P.A. of 1970, the corner points mentioned in lines 1 and 2 above were in conformance with regulations and rules therefore as required in the current manual of survey instructions of the United States Department of the Interior, Bureau of Land Management or by a decree of a Court of Law and/or that the corner points mentioned in lines 3, 4 and 5 above were in conformance with the rules of the Michigan Board of Land Surveyors or by a Decree of a Court of Law; established, re-established, monumented, recovered, found as expressed below:

NOTE: Not more than 2 corners, all in the same town and range, may be recorded on this certificate.

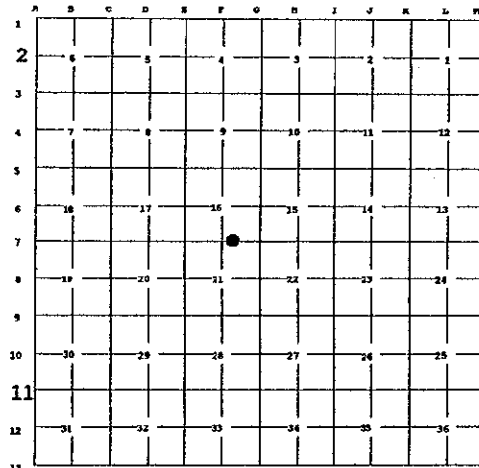

A. Description of original monument and accessories and/or subsequent restoration:

MEANDER CORNER, GLO SET POST 1850 ON SECTION LINE BETWEEN SECTIONS 16 AND 21 AT THE EAST SHORE OF TORCH LAKE. AT 40.54 chaines FROM NE COR SEC 21.

PLAT OF BIRCH BEACH RECORDED NOV 17, 1920 ESTABLISHED A MONUMENT ON SECTION LINE 2512.09' FROM NE COR SEC 21.
PERLA STOUT(CORY HUGHES) 7-14-78 used same mont AS SHOWN ON PLAT ABOVE.78232.
GOSLING CZUBAK(john korr) USED AND WIT SAME MONT 89064.02

3. Description of corner evidence found and/or method applied in restoring or reestablishing corner:

MEANDER CORNER, FOUND 1/2" IRON AND CAP BY JONES WITH NO RECORD AT THE EAST SHORE OF TORCH LAKE 91.80' WEST OF THE ABOVE DESCRIBED MONUMENT. ACCEPTED AS THE MEANDER CORNER ON SECTION LINE BETWEEN SEC 16 and 21.

Ratified by Peer Group
In accordance with
P.O. 345
Antrim Co. Chairman

Arthur L. Lennox
Nov. 10, 1999

2. Description of monument for corner and accessories established to perpetuate locating the position of the corner:

MEANDER CORNER

REMOVED 1/2" IRON AND REPLACED WITH COUNTY MONUMENT.

S62E 22.30' POPLAR 6"
S86E 21.10' ELM 4"
N10E 53.42' ELM 6"
EAST 91.80' CONC. MONT.
WEST 20' TORCH LAKE



Signed by

Date DEC 15, 1999

Surveyor's Michigan License No. 28432