

LAND CORNER RECORDATION CERTIFICATE
Filing Requirement of Act 74, Mich. P.A. 1970

ANTRIM COUNTY MI.
Register of Deeds
Recorded

For corners in

Antrim
(County)

Located In:

MILTON
Corner Code #

12-15-1998 10:17:49

Wanda R. Conway
REGISTER OF DEEDS

1. Public Land Survey	Sec. 35T 29NR 9W	Meander Near I-11
	T R	
	T R	
	T R	
2. Property Controlling in Section	S T R	
	S T R	
3. Miscellaneous Property in Sec.	S T R	
	S T R	

Register of Deeds Stamp & File Number

4. Lot No. _____, Recorded Plat _____
5. Private Claims _____

I, Terry B. Smith, in a field survey on 12-10, 19 98 do hereby state that under requirements of P.A. 74, Michigan P.A. of 1970, the corner points mentioned in lines 1 and 2 above were in conformance with regulations and rules therefore as required in the current manual of survey instructions of the United States Department of the Interior, Bureau of Land Management or by a decree of a Court of Law and /or that the corner points mentioned in lines 3, 4 and 5 above were in conformance with the rules of the Michigan Board of Land Surveyors or by a Decree of a Court of Law; established, re-established, monumented, recovered, found as expressed below:

NOTE: Not more than 2 corners, all in the same town and range, may be recorded on this certificate.

	A	B	C	D	E	F	G	H	I	J	K	L	M
1													
2		6		5		4		3		2		1	
3													
4		7		8		9		10		11		12	
5													
6		18		17		16		15		14		13	
7													
8		19		20		21		22		23		24	
9													
10		30		29		28		27		26		25	
11													
12		31		32		33		34		35		36	
13													

A. Description of original monument and accessories and/or subsequent restoration:

GLO 1853 -- set post on shore of Elk Lake
Certificates by A. Lennox -- 1979, 1980, 1987 & 1990
Certificates by G. Stowe 1990

Ratified by peer group
in accordance with
P.O. 345
Antrim Co. Chairman


Arthur L. Lennox
Arthur L. Lennox
Nov. 18, 1998

B. Description of corner evidence found and/or method applied in restoring or reestablishing corner:

Found found $\frac{1}{2}$ " iron bar & witnesses as set by A. Lennox 1979

C. Description of monument for corner and accessories established to perpetuate locating the position of the corner:

Set Antrim County Monument replacing $\frac{1}{2}$ " steel bar
12" Ash S25°W 26.40
12" Cedar S05°W 39.40
14" R. Pine S65°E 67.85
18" Locust N55°E 66.92

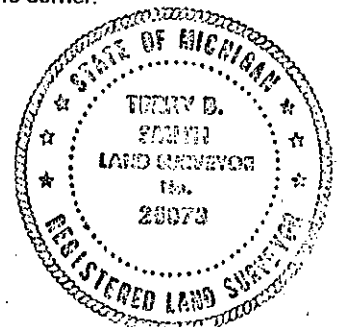

Signed by Terry B. Smith
Surveyor's Michigan License No. 25873

Date DEC. 14, 1998