

MICHIGAN
DEPARTMENT OF CONSERVATION
FORESTRY DIVISION

LAND CORNER RECORD


T. 30 N.R. 5W
T. 30 N.R. 6W Antrim COUNTY

DESCRIPTION OF CORNER Section corner common to Sections 7 - 18 - 12 - 13

CORNER MONUMENT Set 1" pipe with 4" aluminum cap.

DATE MONUMENT PLACED AND WITNESSED 11-20-61

WITNESSES TO CORNER.....

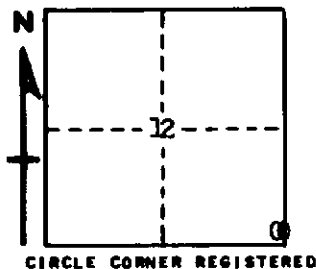

5" H. Maple - North - 8.3 feet

7" Elm - S 89 E - 23.4 feet

AND

DESCRIPTION IN DETAIL AS TO HOW CORNER WAS LOCATED AND IDENTIFIED OR RESTORED.

This corner was restored while making a survey in this area. Corner was set by proportionate measurement for latitude between the 1/4 corner to Sections 1 - 6 and the corner to Sections 18 - 19 - 13 - 24. Longitudinal position established in accord with Hebdon's record bearings for this town line. Could not positively identify any old BT's.

SURVEYOR'S SEAL

SIGNED *Kenneth J. Ostling* DATE 11/21/61
REGISTERED LAND SURVEYOR