


STATE OF MICHIGAN
DEPARTMENT
OF
NATURAL RESOURCES

LAND CORNER RECORD

ANTAIN COUNTY
T 31 N R 5 W

DESCRIPTION OF CORNER E 1/4 corner, Section 13.
CORNER MONUMENT Set 1"x18" pipe over 1/2" red
DATE MONUMENT PLACED AND WITNESSED 10-15-71
WITNESSES TO CORNER.....

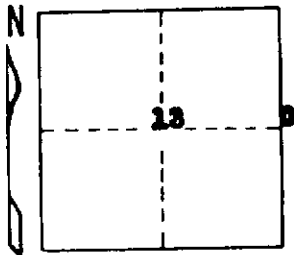


R. Pale N 85 W 87.57'
30" Poplar S 88 E 73.85'
AND

CIRCLE CORNER REGISTERED

DESCRIPTION IN DETAIL AS TO HOW CORNER WAS LOCATED AND IDENTIFIED OR RESTORED.

Found 1/2" red in center of N-S Co. Rd. in line with fence to E & W. Corner fits
DeLator Survey of record at Otsego County Register of Deeds, L 2, P. 330, dated
1925 to 1938.

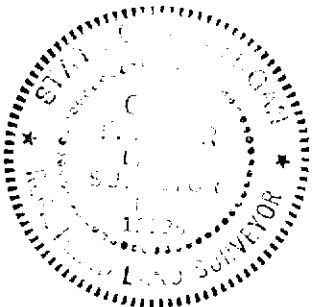

SURVEYOR'S SEAL

SIGNED

R. L. Riser
REGISTERED LAND SURVEYOR 12028

DATE

10-22-71

DISTRIBUTION:

County Courthouse
Area Forester (Regions I & II)
District or Region Surveyor
Forestry Div., Lansing

R 4047
Rev. 10/68