

SURVEY & REMONUMENTATION

FEB 11 1998

ANTRIM COUNTY MI.
Register of Deeds
Recorded

12-02-1997 08:53:33

SECTION

LAND CORNER RECORDATION CERTIFICATE
Filing Requirement of Act 74, Mich. P.A. 1970

CENTRAL LAKE

For corners in

Located in:

Corner Code #

Antrim
(County)

- 1. Public Land Survey 20 T19N R 04W D-7
T___R___
T___R___
T___R___
- 2. Property Controlling in Section S___ T___ R___
S___ T___ R___
- 3. Miscellaneous Property in Sec. S___ T___ R___
S___ T___ R___

Wanda R. Conway
REGISTER OF DEEDS

Register of Deeds Stamp & File Number

119

- 4. Lot No. _____, Recorded Plat _____
- 5. Private Claims _____

	A	B	C	D	E	F	G	H	I	J	K	L	M
1													
2		6		5		4		3		2		1	
3													
4		7		8		9		10		11		12	
5													
6		18		17		16		15		14		13	
7													
8		19		20		21		22		23		24	
9													
10		30		29		28		27		26		25	
11													
12		31		32		33		34		35		36	
13													

I, Terry B. Smith, in a field survey on 12-01, 1997, do hereby state that under requirements of P.A. 74, Michigan P.A. of 1970, the corner points mentioned in lines 1 and 2 above were in conformance with regulations and rules therefore as required in the current manual of survey instructions of the United States Department of the Interior, Bureau of Land Management or by a decree of a Court of Law and/or that the corner points mentioned in lines 3, 4 and 5 above were in conformance with the rules of the Michigan Board of Land Surveyors or by a Decree of a Court of Law; established, re-established, monumented, recovered, found as expressed below:

NOTE: Not more than 2 corners, all in the same town and range, may be recorded on this certificate.

A. Description of original monument and accessories and/or subsequent restoration:

GLO Corner -- 3 1/2" Beech Post
Beech 13" N70E 56L
Beech 14" S42W 52L

B. Description of corner evidence found and/or method applied in restoring or reestablishing corner:

Survey by Lennox & Assoc. 4 ea) 1979 -- 1995
Plat of Minne-Wa-Wa
Survey by L. Feindt 1977
Survey by A. Ranger 1994
LCRC Liber 002 page 189


C. Description of monument for corner and accessories established to perpetuate locating the position of the corner:

Found "T" iron & set Antrim County Monument
6" Poplar N22°W 31.47
6" Ash S05°E 46.30
12" Poplar N50°E 31.30
"T" Iron South 33.00

Ratified by Peer
Group in accordance
with P.A. 345
Antrim Co. Chairman

Arthur L. Lennox
Arthur L. Lennox
Nov. 18, 1997

Signed by T.B. Smith
Surveyor's Michigan License No. 25873

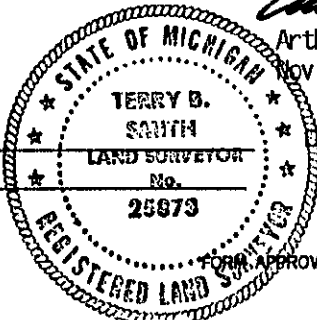

Date 12-01-1997

Liber 00002 Page 0415