

LAND CORNER RECORDATION CERTIFICATE

Authority: 1970 PA 74, MCL 54.205

Surveyor's Name: Stephan J. Szyszkoski

Field Survey Date: October 4, 2017

For corner(s) in: Baraga County

Original Public Land Survey Corner

a. S T 48N R 31W
a. S T 49N R 31W
b. S T 48N R 31W
S T R


Corner Code

F01 (GCDB 340700)
F13 (GCDB 340100)
E03 (GCDB 300600)

Property Corner

S T R
S T R
S T R
S T R

1/16 Corner Code

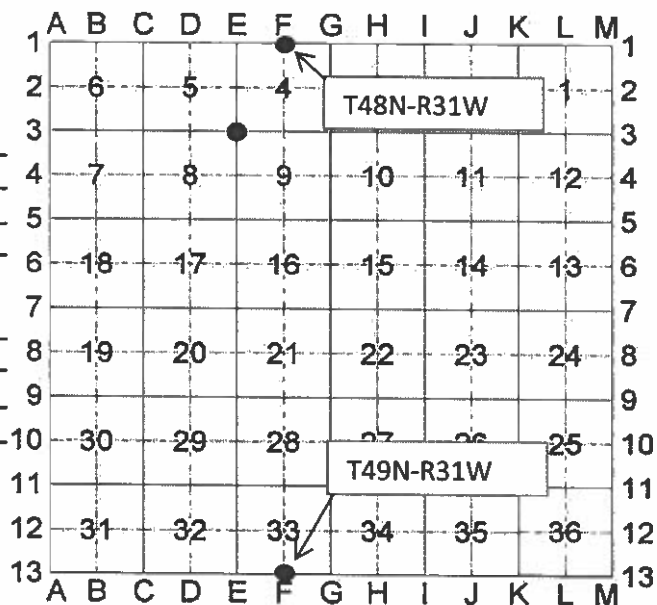

Part A. Corner History

a. Quarter corner common to Section 4 T48N-R31W and Section 33 T49N-R31W. 1846 - Established by John Burt, Deputy Surveyor midway and on the Township Line between Section corners 40.00 chains east and west. Set Sugar post. Spruce 14" N18°E 22 links, Y.Birch 5" N30°W 29 links. Undated Mead Corp. township index of corners for T49N-R31W notes "post" at the corner.

b. Corner common to Sections 4-5-8-9. 1848 - Established by Wells Burt, Deputy Surveyor 79.56 ch. East of C03, 80.06 ch. West of G03, 79.11 ch. South of E01, 80.00 ch. North of E05, 4.63 ch. North of W.Pine 36" on line. Set sugar post. Fir 10" N48°W 44 links, Y.Birch 16" S58°E 21 links.

Part B: Surveyor's Report on Perpetuation, Restoration, Reestablishment, or Monumentation of Corner

a. The original post and accessories were not recovered. Found no evidence of the position of the original corner on the ground. Found no subsequent physical evidence. Reestablished the position for the corner midway and on the Township Line between Section corners 2631.60 feet east and west.

b. Remonumented the corner position at the location of 2 old cedar posts, found set in a rock mound, found at record bearing and distance from the rotting remains of the Y.Birch OBT S58°E 21 links, no marks visible, at record distance north of the 36" W.Pine line tree, now a stump, but certainly the original as no other large stumps were found in the vicinity, 78.86 ch. east of C03, 79.82 ch. west of G03, 79.07 ch. south of E01, and 79.48 ch. north of E05. Two Celotex Corp. location tags face the corner position. Accepted the posts as a careful and faithful perpetuation of the position of the original corner.

Part C: Field Evidence of Perpetuation or Monumentation of Corner

a. Set 1"IDx28" I.pipe with 2" alum. MDNR cap.
Set measuring nail with MDNR tag in the side of:
7" W.Birch S77°W 16.8' mrkd "1/4S NBT"
7" W.Birch N43°W 13.4' do
7" W.Birch S86°E 8.6' do
6" Poplar S12°E 10.3' do
Set sq'd cedar post adjacent.
E= 7908863.49 N= 201760.84

b. Set 1"IDx28" I.pipe with 2" alum. MDNR cap.
Set measuring nail with MDNR tag in the side of:
15" Spruce N24°W 10.35' mrkd "S5 NBT"
10" Maple N66°E 24.1' "S4 NBT"
7" Maple S74°E 31.4' "S9 NBT"
8" Maple S48°W 11.05' "S8 NBT"
Set sq'd cedar post adjacent.
E= 7908026.36 N= 200182.96

Bearings are magnetic. Coordinates are MCS83 in meters, NAD83(2011) Epoch 2010.09 station

Stephan J. Szyszkoski

02/05/2018

Professional Surveyor's License No.: 33986

page 1 of 1

Prepared By: S.J. Szyszkoski for the Michigan Dept. of Natural Resources, 427 N. US41 Baraga, MI 49908

