

LAND CORNER RECORDATION CERTIFICATE

FILING REQUIREMENT OF ACT 74, MICH. P.A.1970

FOR CORNERS OF—:	LOCATED IN—:	CORNER CODE NUMBER
1. PUBLIC LAND SURVEY _____	T. 48 N. R. 33 W.	E4
2. PROPERTY CONTROL- ING IN SECTION 9 _____	T. 48 N. R. 33 W.	3, 8
3. MISCELLANEOUS PROPERTY IN SECTION _____	T. _____ N. R. _____ E.	
4. LOT NO. _____, RECORDED PLAT _____		
5. PRIVATE CLAIMS _____		

REGISTER OF DEEDS STAMP AND
FILING NUMBER

I, Keith L. Sackett do hereby certify that under requirements of P.A. 74, Michigan P.A. of 1970, the corner points mentioned in lines 1 and 2 above (identified with circles on index code diagram—over) were, in a field survey on June 17 19 75, established, re-established, monumented, re-monumented, recovered or restored as expressed below and in conformance with regulations and rules therefore as required in the current manual of survey instructions of the United States Department of the Interior, Bureau of Land Management or by a decree of a court of law. Furthermore, that the corner points mentioned in lines 3, 4 and 5 above were, in a field survey on _____ 19____, found, recovered, restored, established or re-established as expressed below and in conformance with the rules of the Michigan State Board of Registration for Land Surveyors or, by a Decree of a Court of law:

A. Description of original monument and accessories and/or subsequent restoration:

Corner E4: Original corner or accessories not found.

Corner 3: Not set on original survey or subsequently apparently.

Corner 8: Not set on original survey or subsequently apparently.

B. Description of corner evidence found and/or method applied in restoring or re-establishing corner:

Corner E4: Corner re-established at intersection of blazed lines and old cutting edges. Fits good with land calls and section corners north and south.

Corners 3 and 8: Established on subdivision of section.

C. Description of monument for corner and accessories established to perpetuate locating the position of the corner:

Corner E4: Set 1" I.D. x 36" iron pipe with 4" aluminum cap.
8" Sugar N17°E (Mag.) 12.0 ft. 1/4S, NBT
8" " S08°E (Mag.) 8.3 ft. 1/4S, NBT
4" " N58°W (Mag.) 5.6 ft. Tree squared

Corner 3: Set 1" I.D. x 36" iron pipe with 4" aluminum cap.
20" Sugar N27°E (Mag.) 11.1 ft. 1/16S, BT
22" " S01°E (Mag.) 4.9 ft. 1/16 S, BT

Corner 8: Set 1" I.D. x 36" iron pipe with 4" aluminum cap.
14" Cedar N77°N (Mag.) 11.9 ft. 1/16S, BT
10" " S48°E (Mag.) 12.9 ft. 1/16S, BT

SIGNED BY _____ DATE _____

SURVEYOR'S MICHIGAN REGISTRATION NO. _____

(SEAL)


FOR STATE AND UNITED STATES AGENCIES:

SIGNED BY _____ DATE _____

APPROVED AND SIGNED BY Keith L. Sackett DATE November 19, 1975

CHIEF OF SURVEY PARTY
MICHIGAN REGISTERED LAND SURVEYOR
Keith L. Sackett
Dept. of Natural Resources

SURVEYOR'S MICHIGAN REGISTRATION NO. 19006

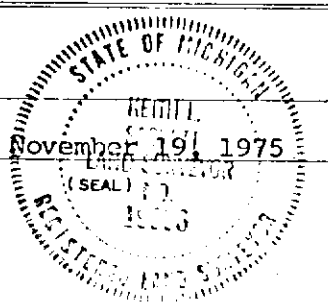


CORNER NUMBERING CODE DIAGRAMS FOR IDENTIFYING LAND CORNER RECORDATIONS AND INDEXING

FOR PUBLIC LAND SURVEY CORNERS IN THE
T.48N, R.33W (MENTIONED OVER)

	A	B	C	D	E	F	G	H	I	J	K	L	M
1													
2	6		5		4		3		2		1		
3													
4	7		8		9		10		11		12		
5													
6	18		17		16		15		14		13		
7													
8	19		20		21		22		23		24		
9													
10	30		29		28		27		26		25		
11													
12	31		32		33		34		35		36		
13													

Apply letter prefix for corner points encircled above
for identifying corner recordation numbers over.

FOR PROPERTY CONTROLLING AND MISC.
PROPERTY CORNERS WITHIN THE SECTION
(MENTIONED OVER AND EXCLUDE LOT CORNER)

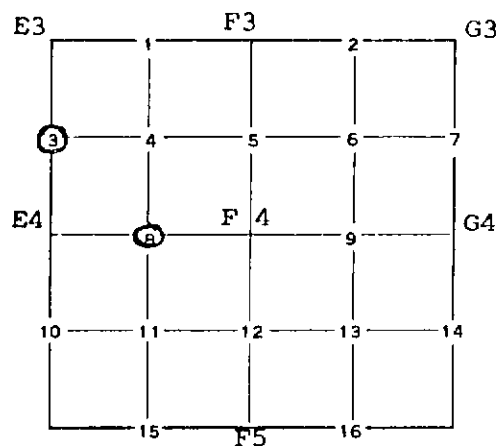

1. Above coded numbers are positioned on 1/16 fractional lines of the section.
2. Township corner code numbers shall be applied to corners of above typical section not numbered.
3. Miscellaneous property corners within a section, located at points other than numbered above, shall be referenced to at least two of above corner code numbers.
4. Private claim corners to be tied to rectangular land corners if possible - sketch required below.

EXPLANATORY SKETCH IF NECESSARY -- BELOW