

LAND CORNER RECORDATION CERTIFICATE
Filing Requirement of Act 74, Mich. P.A. 1970 as Amended

For corners in

Baraga (County)	Located In:	Corner Code #
1. Public Land Survey	T _____ R _____	_____
	T _____ R _____	_____
	T _____ R _____	_____
2. Property Controlling in Section	S 36 T 48N R 34W	3
	S 36 T 48N R 34W	10
	S _____ T _____ R _____	_____
3. Miscellaneous Property in Sec.	S _____ T _____ R _____	_____
	S _____ T _____ R _____	_____
4. Lot No. _____, Recorded Plat _____		
5. Private Claims _____		

Register of Deeds Stamp & File Number

	A	B	C	D	E	F	G	H	I	J	K	L	M
1													
2	6		5		4		3		2		1		
3													
4	7		8		9		10		11		12		
5													
6	18		17		16		15		14		13		
7													
8	19		20		21		22		23		24		
9													
10	30		29		28		27		26		25		
11													
12	31		32		33		34		35		36		
13													

I, Stephan J. Szyszkoski, in a field survey on 06/01/2011 do hereby state that under requirements of P.A. 74, Michigan P.A. of 1970, the corner points mentioned in lines 1 and 2 above were in conformance with regulations and rules therefore as required in the current manual of survey instructions of the United States Department of the Interior, Bureau of Land Management or by a decree of a Court of Law and /or that the corner points mentioned in lines 3, 4 and 5 above were in conformance with the rules of the Michigan Board of Land Surveyors or by a Decree of a Court of Law; established, re-established, monumented, recovered, found as expressed below:

NOTE: Not more than 2 corners, all in the same town and range, may be recorded on this certificate.

A. Description of original monument and accessories and/or subsequent restoration:

(3-Sec. 36) North 1/16 corner between Sections 35 and 36. 1978 - Established by K.L.Sackett RLS midway and on line between corners North and South. Set 1"IDx24" I.pipe with 4" aluminum cap buried in west shoulder of old US-141. 9" Maple S59W 18.1', 6" Balsam N50W 37.8', 4" Balsam S75E 38.1'.

(10-Sec. 36) South 1/16 corner between Sections 35 and 36. 1978 - Established by K.L.Sackett RLS midway and on line between corners North and South. Set 1"IDx24" I.pipe with 4" aluminum cap buried in old US-141. 10" Sugar N81W 25.9', 8" Sugar S21E 49.9', 6" Sugar N40E 29.4'.

B. Description of corner evidence found and/or method applied in restoring or reestablishing corner:

(3-Sec. 36) The 1978 monument was found disturbed and out of position. Reestablished the corner position midway and on the Section line between Section corner 1322.58' north and Quarter corner 1322.58' south. From the position thus reestablished, the two remaining 1978 witness trees check (1978 measurements were made to a notch in the face of the tree at the root crown).

(10-Sec. 36) The 1978 monument and accessories were not recovered. Reestablished the position for the corner midway and on the Section line between Section corner 1322.56' South and Quarter corner 1322.56' North.

C. Description of monument for corner and accessories established to perpetuate locating the position of the corner:


(3) Set 1"IDx32" I.pipe with 4" alum. MDNR cap. Set measuring nail with MDNR tag in the side of:
10" Maple S60W 18.6' old blazes 1978 BT
10" Balsam N49W 37.85' do do
8" Balsam N07W 23.85' mrkd "1/16S BT"
6" Y.Birch S51E 41.05' do
Set sq'd cedar post adjacent.
Bearings are magnetic.

(10) Set 1"IDx32" I.pipe with 4" alum. MDNR cap
6" b.g. Set meas. nail w/ MDNR tag in the side of:
7" Sugar N53E 37.25' mrkd "1/16S BT"
14" Y.Birch N87E 35.0' do
6" Sugar S38W 58.2' do
5" Sugar N72W 33.95' do
Set Sq'd Cedar post with location poster
10' east of the corner. Bearings are magnetic.

Signed by Stephan J. Szyszkoski
Surveyor's Michigan License No. 33986

Date 06/29/2011

For the Michigan Department of Natural Resources, Forest Management Division

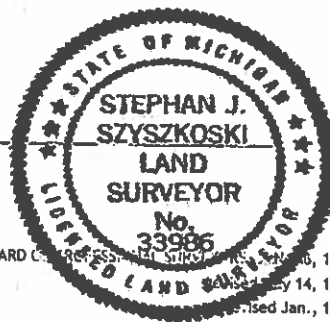

16634

16635