

LAND CORNER RECORDATION CERTIFICATE  
Filing Requirement of Act 74, Mich. P.A. 1970 as Amended

For corners in

Baraga (County)	Located In:	Corner Code #
1. Public Land Survey	T R	
	T R	
	T R	
2. Property Controlling in Section	S 11 T 49N R 32W	13
	S T R	
	S T R	
3. Miscellaneous Property in Sec.	S T R	
	S T R	
4. Lot No. , Recorded Plat		
5. Private Claims		

Register of Deeds Stamp & File Number

	A	B	C	D	E	F	G	H	I	J	K	L	M
1													
2	6	5	4	3	2	1							
3													
4	7	8	9	10	11	12							
5													
6	16	17	18	19	20	21	22	23	24				
7													
8	13	20	21	22	23	24							
9													
10	30	29	28	27	26	25							
11													
12	31	32	33	34	35	36							
13													

I, Stephan J. Szyszkoski, in a field survey on 12/08/2011 do hereby state  
that under requirements of P.A. 74, Michigan P.A. of 1970, the corner points mentioned in lines 1 and 2  
above were in conformance with regulations and rules therefore as required in the current manual of survey  
instructions of the United States Department of the Interior, Bureau of Land Management or by a decree of  
a Court of Law and /or that the corner points mentioned in lines 3, 4 and 5 above were in conformance with  
the rules of the Michigan Board of Land Surveyors or by a Decree of a Court of Law; established,  
re-established, monumented, recovered, found as expressed below:

NOTE: Not more than 2 corners, all in the same town and range, may be recorded  
on this certificate.

A. Description of original monument and accessories and/or subsequent restoration:

(13-Sec. 11) Southeast 1/16 corner, Section 11. Not established in the original survey.

B. Description of corner evidence found and/or method applied in restoring or reestablishing corner:

(13-Sec. 11) Established the corner at the intersection of straight lines connecting opposite 1/16  
corners. The position for the corner falls in the low lands adjacent to the Silver River and was not  
monumented. Established two Witness corners to the 1/16 corner: 30.00' south of the 1/16 corner  
position on the East 1/16 line, and 40.00' east of the 1/16 corner position on the South 1/16 line.

C. Description of monument for corner and accessories established to perpetuate locating the position of the corner:

(13) Set 1"IDx32" I.pipe with 4" alum. MDNR cap  
30.00' south of the corner position and on the  
East 1/16 line for a WITNESS CORNER.  
Set measuring nail with MDNR tag in the side of:  
6" Spruce N68E 5.8' mrkd "WC BT"  
7" Cedar S29W 21.3' do  
17" W.Pine S85W 13.85' do  
9" Cedar N37W 7.1' do  
Set sq'd Cedar post adjacent.  
Bearings are magnetic.

(13) Set 1"IDx32" I.pipe with 4" alum. MDNR cap  
40.00' east of the corner position and on the  
South 1/16 line for a WITNESS CORNER.  
Set measuring nail with MDNR tag in the side of:  
7" Spruce N38E 8.1' mrkd "WC BT"  
9" Maple S42E 18.3' do  
9" Spruce S24W 2.3' do  
7" Balsam N22W 4.1' do  
Bearings are magnetic. The monument projects  
about 24" a.g., driven through a large spruce  
root to refusal against the bedrock below.

Signed by Stephan J. Szyszkoski  
Surveyor's Michigan License No. 33986


Date 07/27/2011

For the Michigan Department of Natural Resources, Forest Management Division

16657

16658

FORM APPROVED BY MICHIGAN STATE BOARD OF PROFESSIONAL SURVEYORS

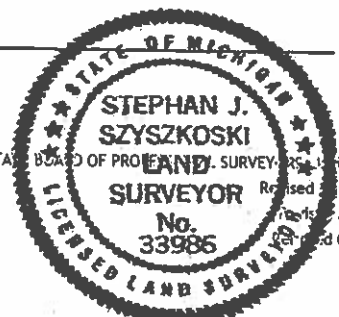

Revised Jan. 14, 1975  
Revised Jan., 1983  
Revised Oct., 1995