

LAND CORNER RECORDATION CERTIFICATE
Filing Requirement of Act 74, Mich. P.A. 1970 as Amended

For corners in

Baraga (County)	Located In:	Corner Code #
1. Public Land Survey	T 49N R 32W	K2
	T 49N R 32W	M4
	T _____ R _____	_____
2. Property Controlling in Section	S _____ T _____ R _____	_____
	S _____ T _____ R _____	_____
	S _____ T _____ R _____	_____
3. Miscellaneous Property in Sec.	S _____ T _____ R _____	_____
	S _____ T _____ R _____	_____
4. Lot No. _____, Recorded Plat _____		
5. Private Claims _____		

Register of Deeds Stamp & File Number

	A	B	C	D	E	F	G	H	I	J	K	L	M
1													
2	6		5		4		3		2		1		
3													
4	7		8		9		10		11		12		
5													
6	18		17		16		15		14		13		
7													
8	19		20		21		22		23		24		
9													
10	30		29		28		27		26		25		
11													
12	31		32		33		34		35		36		
13													

I, Stephan J. Szyszkoski, in a field survey on K2 05/23/2011 do hereby state
that under requirements of P.A. 74, Michigan P.A. of 1970, the corner points mentioned in lines 1 and 2
above were in conformance with regulations and rules therefore as required in the current manual of survey
Instructions of the United States Department of the Interior, Bureau of Land Management or by a decree of
a Court of Law and /or that the corner points mentioned in lines 3, 4 and 5 above were in conformance with
the rules of the Michigan Board of Land Surveyors or by a Decree of a Court of Law; established,
re-established, monumented, recovered, found as expressed below:

NOTE: Not more than 2 corners, all in the same town and range, may be recorded
on this certificate.

A. Description of original monument and accessories and/or subsequent restoration:

(K2) Quarter corner common to Sections 1 and 2. 1852 - Established by Guy Carleton Deputy Surveyor
on the section line between Section corners 40.00 chains south and 39.84 chains north. Set post.
Y.Birch 5" S36E 27 links, White Birch 11" S78W 24 links. 1942 - Norman T. Thompson RLS did not
recover the original corner and reestablished the corner position [method not stated in his notes,
but it appears he may have reestablished the position 40.00 chains north of the Section corner K3].
Set spruce post. NBTs: W.Birch 10" N47W 10.2', Maple 6" S25E 12.4'.

(M4) Quarter corner common to Section 12 T49N-R32W and Section 7 T49N-R31W. 1846 - Established by
Wm.A.Burt Deputy Surveyor midway and on the Range line between Section corners 40.00 chains north and
south and south of the Meander corners on the north and south shores of Fisher Lake 11.93 chains and
1.6 chains north, respectively. Set Tamarack post. Spruce 12" N70E 29 links, Tamk 7" S18W 28 links.

B. Description of corner evidence found and/or method applied in restoring or reestablishing corner:

(K2) The original post and accessories were not recovered. Found no acceptable evidence of the
position of the original corner on the ground. Reestablished the corner at the proportionate
position, on the Section line between Section corners 2623.90' south and 2613.40' north, being
proportionate to the original record.

(M4) The original post and accessories were not recovered. Found no acceptable evidence of the
position of the original corner on the ground. Found no evidence of the two original meander corners
nor their accessories at Fisher Lake. I reestablished the position for the corner midway and on the
Range line between Section corners 2620.16' north and south. From the position thus established, I
found an old Ford Motor Co. location poster on a wood post 21.5' north.

C. Description of monument for corner and accessories established to perpetuate locating the position of the corner:


(K2) Set 1"IDx32" I.pipe with 4" alum. MDNR cap.
Set measuring nail with MDNR tag in the side of:
13" Maple N04W 8.85' mrkd "1/14S NBT"
6" Maple S36E 4.3' do
10" Sugar S22W 12.9' do
8" Sugar N79W 24.3' do
Set sq'd Cedar post adjacent.
Bearings are magnetic.

(M4) Set 1"IDx32" I.pipe with 4" alum. MDNR cap.
Set measuring nail with MDNR tag in the side of:
16" Cedar N03E 21.75' mrkd "1/4S NBT"
9" Cedar S75E 16.8' do
18" Cedar S11W 3.25' do
7" Cedar N84W 26.35' do
Set sq'd Cedar post adjacent.
Bearings are magnetic.

Signed by Stephan J. Szyszkoski
Surveyor's Michigan License No. 33986

Date 07/27/2011

For the Michigan Department of Natural Resources, Forest Management Division

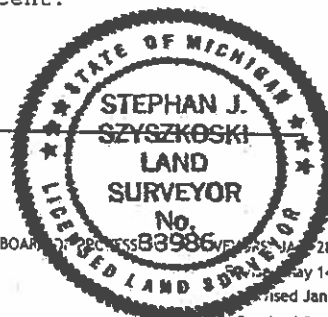

16664

16660