

LAND CORNER RECORDATION CERTIFICATE
Filing Requirement of Act 74, Mich. P.A. 1970 as Amended

For corners in

Baraga (County)	Located In:	Corner Code #
1. Public Land Survey	T R	
	T R	
	T R	
2. Property Controlling in Section	S 17 T 49N R 32W	14
	S 17 T 49N R 32W	12
	S T R	
3. Miscellaneous Property in Sec.	S T R	
	S T R	
4. Lot No. , Recorded Plat		
5. Private Claims		

Register of Deeds Stamp & File Number

1	A	B	C	D	E	F	G	H	I	J	K	L	M
2		6		5		4		3		2		1	
3													
4		7		8		9		10		11		12	
5													
6		18		17		16		15		14		13	
7													
8		19		20		21		22		23		24	
9													
10		30		29		28		27		26		25	
11													
12		31		32		33		34		35		36	
13													

I, Stephan J. Szyszkoski, in a field survey on 14 08/30/2011 do hereby state
that under requirements of P.A. 74, Michigan P.A. of 1970, the corner points mentioned in lines 1 and 2
above were in conformance with regulations and rules therefore as required in the current manual of survey
instructions of the United States Department of the Interior, Bureau of Land Management or by a decree of
a Court of Law and /or that the corner points mentioned in lines 3, 4 and 5 above were in conformance with
the rules of the Michigan Board of Land Surveyors or by a Decree of a Court of Law; established,
re-established, monumented, recovered, found as expressed below:

NOTE: Not more than 2 corners, all in the same town and range, may be recorded
on this certificate.

A. Description of original monument and accessories and/or subsequent restoration:

(14-Sec. 17) South 1/16 corner between Sections 16 and 17. Not previously established.

(12-Sec. 17) South 1/16 corner of Section 17. Not previously established.

B. Description of corner evidence found and/or method applied in restoring or reestablishing corner:

(14-Sec. 17) Established the corner midway and on a straight line between Quarter corner E6 1292.29'
north and Section corner E7 1292.29' south.

(12-Sec. 17) Established the position for the corner midway and on a straight line between Center of
Section 17 1303.71' north and Quarter corner D7 1303.71' south.

C. Description of monument for corner and accessories established to perpetuate locating the position of the corner:


(14) Set 1"IDx32" I.pipe with 4" alum. MDNR cap.
Set measuring nail with MDNR tag in the side of:
9" Spruce N57W 16.65' mrkd "1/16S BT"
12" B.Ash North 23.1' do
13" Spruce S65E 20.7' do
4" Balsam S30E 9.3' do
Set sq'd cedar post adjacent.
Bearings are magnetic.

(12) Set 1"IDx32" I.pipe with 4" alum. MDNR cap.
Set measuring nail with MDNR tag in the side of:
2" Y.Birch N24E 3.8' mrkd "X X"
12" Spruce S03E 12.85' "1/16S BT"
6" Maple S59W 9.6' do
9" twin Cedar S88W 19.85' do
Set sq'd cedar post adjacent.
Bearings are magnetic.

Signed by Stephan J. Szyszkoski
Surveyor's Michigan License No. 33986

Date 12/05/2011

For the Michigan Department of Natural Resources, Forest Management Division

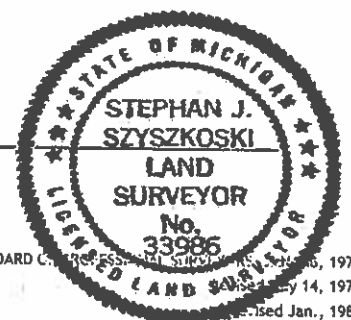

16782

16784