

**LAND CORNER RECORDATION CERTIFICATE**  
**Filing Requirement of Act 74, Mich. P.A. 1970 as Amended**

For corners in

Baraga	Located In:	Corner Code #
(County)		
1. Public Land Survey	T _____ R _____	_____
	T _____ R _____	_____
	T _____ R _____	_____
2. Property Controlling in Section	S 31 T 49N R 34W	3
	S _____ T _____ R _____	(GCDB 100160)
	S 31 T 49N R 34W	10
3. Miscellaneous Property in Sec.	S _____ T _____ R _____	(GCDB 100120)
	S _____ T _____ R _____	_____
4. Lot No. _____, Recorded Plat _____		
5. Private Claims _____		

Register of Deeds Stamp & File Number

	A	B	C	D	E	F	G	H	I	J	K	L	M
1													
2		6		5		4		3		2		1	
3													
4		7		8		9		10		11		12	
5													
6		18		17		16		15		14		13	
7													
8		19		20		21		22		23		24	
9													
10		30		29		28		27		26		25	
11													
12		31		32		33		34		35		36	
13													

I, Stephan J. Szyszkoski, in a field survey on 02/03/16 do hereby state that under requirements of P.A. 74, Michigan P.A. of 1970, the corner points mentioned in lines 1 and 2 above were in conformance with regulations and rules therefore as required in the current manual of survey instructions of the United States Department of the Interior, Bureau of Land Management or by a decree of a Court of Law and /or that the corner points mentioned in lines 3, 4 and 5 above were in conformance with the rules of the Michigan Board of Land Surveyors or by a Decree of a Court of Law; established, re-established, monumented, recovered, found as expressed below:

**NOTE:** Not more than 2 corners, all in the same town and range, may be recorded on this certificate.

**A. Description of original monument and accessories and/or subsequent restoration:**

(3-Sec. 31) North 1/16 corner between Section 31 T49N-R34W and Section 36 T49N-R35W. Not previously monumented.

(10-Sec. 31) South 1/16 corner between Section 31 T49N-R34W and Section 36 T49N-R35W. Not previously monumented.

**B. Description of corner evidence found and/or method applied in restoring or reestablishing corner:**

(3-Sec. 31) Established the position for the corner midway and on the Range Line between Section corner 1323.88' north and Quarter corner 1323.88' south.

(10-Sec. 31) Established the position for the corner midway and on the Range Line between Quarter corner 1316.80' north and Township corner 1316.80' south.

**C. Description of monument for corner and accessories established to perpetuate locating the position of the corner:**


(3) Set 1"IDx28" I.pipe with 2" alum. MDNR cap. Set measuring nail with MDNR tag in the side of:  
 5" J.Pine N47°W 2.2' mrkd "1/16S BT"  
 7" J.Pine N55°E 10.65' do  
 5" J.Pine S50°E 13.05' do  
 6" J.Pine S10°E 19.3' do  
 Set sq'd cedar post adjacent.  
 E= 7876236.434 N= 203597.435

(10) Set 1"IDx28" I.pipe with 2" alum. MDNR cap. Set measuring nail with MDNR tag in the side of:  
 8" J.Pine S85°E 71.45' mrkd "1/16S BT"  
 7" J.Pine S73°E 75.55' do  
 11" J.Pine (burned, dead) S40°W 26.75' do  
 7" J.Pine (burned, dead) N02°W 43.6' do  
 Set sq'd cedar post adjacent.  
 E= 7876214.067 N= 202792.976

**Bearings are magnetic.** Coordinates are MCS83 in meters, NAD83(2011) Epoch 2010.00 datum  
 Coord. Ref.=NGS PID RL0476: N= 196482.409 m. E= 7879234.515 m.

Signed by Stephan J. Szyszkoski  
 Surveyor's Michigan License No. 33986

Date 02/24/2016

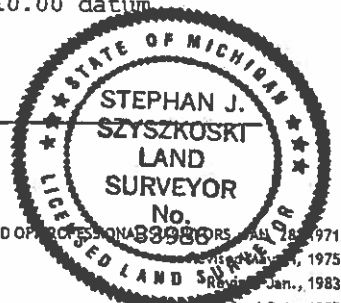

For the Michigan Department of Natural Resources, Forest Resources Division