

LAND CORNER RECORDATION CERTIFICATE
Filing Requirement of Act 74, Mich. P.A. 1970 as Amended

For corners in

Baraga (County)	Located In:	Corner Code #
1. Public Land Survey	T 50N R 34W	A7
2. Property Controlling in Section	S T R	
3. Miscellaneous Property in Sec.	S T R	
4. Lot No. , Recorded Plat		
5. Private Claims		

Register of Deeds Stamp & File Number

	A	B	C	D	E	F	G	H	I	J	K	L	M
1													
2	6		5		4		3		2		1		
3													
4	7		8		9		10		11		12		
5													
6	18		17		16		15		14		13		
7													
8	19		20		21		22		23		24		
9													
10	30		29		28		27		26		25		
11													
12	31		32		33		34		35		36		
13													

I, Stephan J. Szyszkoski, in a field survey on 04/09/13 do hereby state
that under requirements of P.A. 74, Michigan P.A. of 1970, the corner points mentioned in lines 1 and 2
above were in conformance with regulations and rules therefore as required in the current manual of survey
instructions of the United States Department of the Interior, Bureau of Land Management or by a decree of
a Court of Law and /or that the corner points mentioned in lines 3, 4 and 5 above were in conformance with
the rules of the Michigan Board of Land Surveyors or by a Decree of a Court of Law; established,
re-established, monumented, recovered, found as expressed below:

NOTE: Not more than 2 corners, all in the same town and range, may be recorded
on this certificate.

A. Description of original monument and accessories and/or subsequent restoration:


(A7) Corner common to Sections 18-19 T50N-R34W and Sections 13-24 T50N-R35W. 1961 - Billy D. Buckler
RLS reestablished the corner position by single proportionate measurement along the Township line.
Found old squared Cedar post east of the corner. Set 1"ID pipe with 4" aluminum cap. 8" Hard Maple
N12°W 4.5 links, 15" Y.Birch S20°W 33.5 links, 5" Soft Maple N49°E 21.5 links. 1984 - R.L.Drahn RLS,
L4 of LCR, P101, found the 1961 monument at substantial record bearing and distance from the 1961
accessories and from stump holes and mounds that correspond to the original GLO bearing trees, and made
new witnesses: 5" Red Maple N89°W 11.95', 4" Sugar Maple N77°E 2.22', 6" Sugar Maple S24°E 14.33',
steel sign post N80°W 1.85'.

B. Description of corner evidence found and/or method applied in restoring or reestablishing corner:

(A7) Found no acceptable evidence of the position of the original corner on the ground. Found the 1961
monument in good condition and at substantial record bearing and distance from two remaining 1984
witnesses and from two remaining 1961 witnesses. Determined that the 1961 position for the corner is
erroneous, it being S74°W 36.4' distant from the proportionate position along the township line between
perpetuated original corners at A5 and A8, these being the corners used in the 1961 survey. I discount
the holes noted in the 1984 record as being coincidental and do not accept them as the remains of the
original bearing trees. I do not accept the 1961 monument as the reestablishment of the original
corner position and I apply the 1961 method to reestablish the original position by single
proportionate measurement between perpetuated original corners at A8 2632.70 ft. south and at A5
5265.40 ft. north.

C. Description of monument for corner and accessories established to perpetuate locating the position of the

(A7) Set 1"IDx32" I.pipe with 4" alum. MDNR cap.
Set measuring nail with MDNR tag in the side of:
9" Sugar N35°W 13.95' mrkd "S13 NBT"
6" Sugar N76°E 16.15' "S18 NBT"
9" Sugar S11°E 40.25' "S19 NBT"
5" Maple S83°W 12.9' "S24 NBT"
Reset Nat'l Forest Boundary sign post West 1.0'
Relocated the USFS bearing tree placards to the new
bearing trees. E=
7876549.549 N= 216798.700

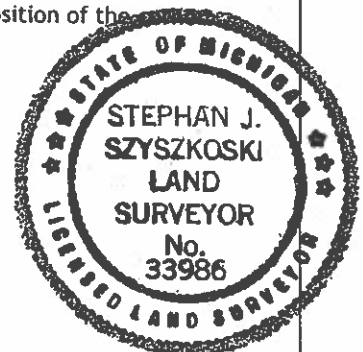

Bearings are magnetic. Coordinates are MCS83 in meters (NAD83(2011) Datum).

Coord. Ref.=NGS PID D11837: N= 221257.624 m. E= 7884435.168 m.

Signed by Stephan J. Szyszkoski
Surveyor's Michigan License No. 33986

Date 07/02/2013

For the Michigan Department of Natural Resources, Forest Resources Division