

**LAND CORNER RECORDATION CERTIFICATE**  
 Filing Requirement of Act 74, Mich. P.A. 1970 as Amended

For corners in

Baraga <small>(County)</small>	Located In:	Corner Code #
1. Public Land Survey	T _____ R _____	_____
	T _____ R _____	_____
	T _____ R _____	_____
2. Property Controlling in Section	S <u>22</u> T <u>51N</u> R <u>32W</u>	<u>13</u>
	S <u>23</u> T <u>51N</u> R <u>32W</u>	<u>12</u>
	S _____ T _____ R _____	_____
3. Miscellaneous Property in Sec.	S _____ T _____ R _____	_____
	S _____ T _____ R _____	_____
4. Lot No. _____, Recorded Plat _____		
5. Private Claims		

Register of Deeds Stamp & File Number

	A	B	C	D	E	F	G	H	I	J	K	L	M
1													
2	6	5	4	3	2	1							
3													
4	7	8	9	10	11	12							
5													
6	18	17	16	15	14	13							
7													
8	19	20	21	22	23	24							
9													
10	30	29	28	27	26	25							
11													
12	31	32	33	34	35	36							
13													

1, Stephan J. Szyszkoski, in a field survey on 13 03/23/2011  
12 03/23/2011 do hereby state  
 that under requirements of P.A. 74, Michigan P.A. of 1970, the corner points mentioned in lines 1 and 2  
 above were in conformance with regulations and rules therefore as required in the current manual of survey  
 instructions of the United States Department of the Interior, Bureau of Land Management or by a decree of  
 a Court of Law and /or that the corner points mentioned in lines 3, 4 and 5 above were in conformance with  
 the rules of the Michigan Board of Land Surveyors or by a Decree of a Court of Law; established,  
 re-established, monumented, recovered, found as expressed below:

**NOTE:** Not more than 2 corners, all in the same town and range, may be recorded  
 on this certificate.

**A. Description of original monument and accessories and/or subsequent restoration:**

- (13-Sec. 22) Southeast 1/16 corner, Section 22. Not established in the original survey.
- (12-Sec. 23) South 1/16 corner, Section 23. Not established in the original survey.

**B. Description of corner evidence found and/or method applied in restoring or reestablishing corner:**


- (13-Sec. 22) Established the corner at the intersection of straight lines connecting opposite 1/16  
 corners. From the corner thus established, I found a 3/4" iron pipe, not of record, 67 ft. north,  
 not accepted as marking the position for the corner.
- (12-Sec. 23) Established the corner midway and on a straight line between Quarter corner 1317.56'  
 south and the intersection of 1/4 lines of Section 23, 1317.56' north.

**C. Description of monument for corner and accessories established to perpetuate locating the position of the corner:**

- |   |   |
|---|---|
| (13) Set 1"IDx32" I.pipe with 4" alum. MDNR cap.<br>Set measuring nail with MDNR tag in the side of:<br>6" Sugar N54E 14.75' mrkd "1/16S BT"<br>8" Sugar S34E 20.45' do<br>10" Sugar S28W 9.85' do<br>11" Sugar N63W 11.95' do<br>Set sq'd Cedar post adjacent.<br>Bearings are magnetic. | (12) Set 1"IDx32" I.pipe with 4" alum. MDNR cap.<br>Set measuring nail with MDNR tag in the side of:<br>3" Oak N18E 3.45' mrkd "1/16S BT"<br>4" Balsam N82E 12.1' do<br>9" Maple S09W 29.55' do<br>5" Balsam N18W 32.7' do<br>Set sq'd Cedar post adjacent.<br>Bearings are magnetic. |
|---|---|

Signed by Stephan J. Szyszkoski  
 Surveyor's Michigan License No. 33986

Date 08/30/2011

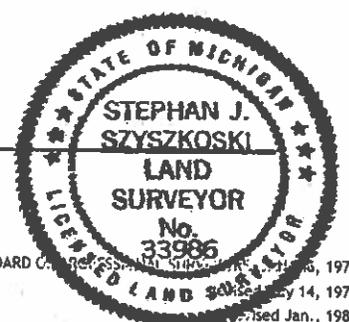

For the Michigan Department of Natural Resources, Forest Management Division

16716  
16717